


Number: 20200009900
Recorded: 11/27/2019 at 1:29:29.0 PM
County Recording Fee: \$7.00
Iowa E-Filing Fee: \$3.13
Combined Fee: \$10.13
Revenue Tax:
Sandie L. Smith, RECORDER
Black Hawk County, Iowa

Prepared by/Return to: FEHR GRAHAM, 128 S. Vine Street, West Union IA 52175 – Ph: (563)422-5131

UNITED STATES PUBLIC LAND SURVEY CORNER CERTIFICATE
BLACK HAWK COUNTY, IOWA
SECTION 15-T90N-R11W

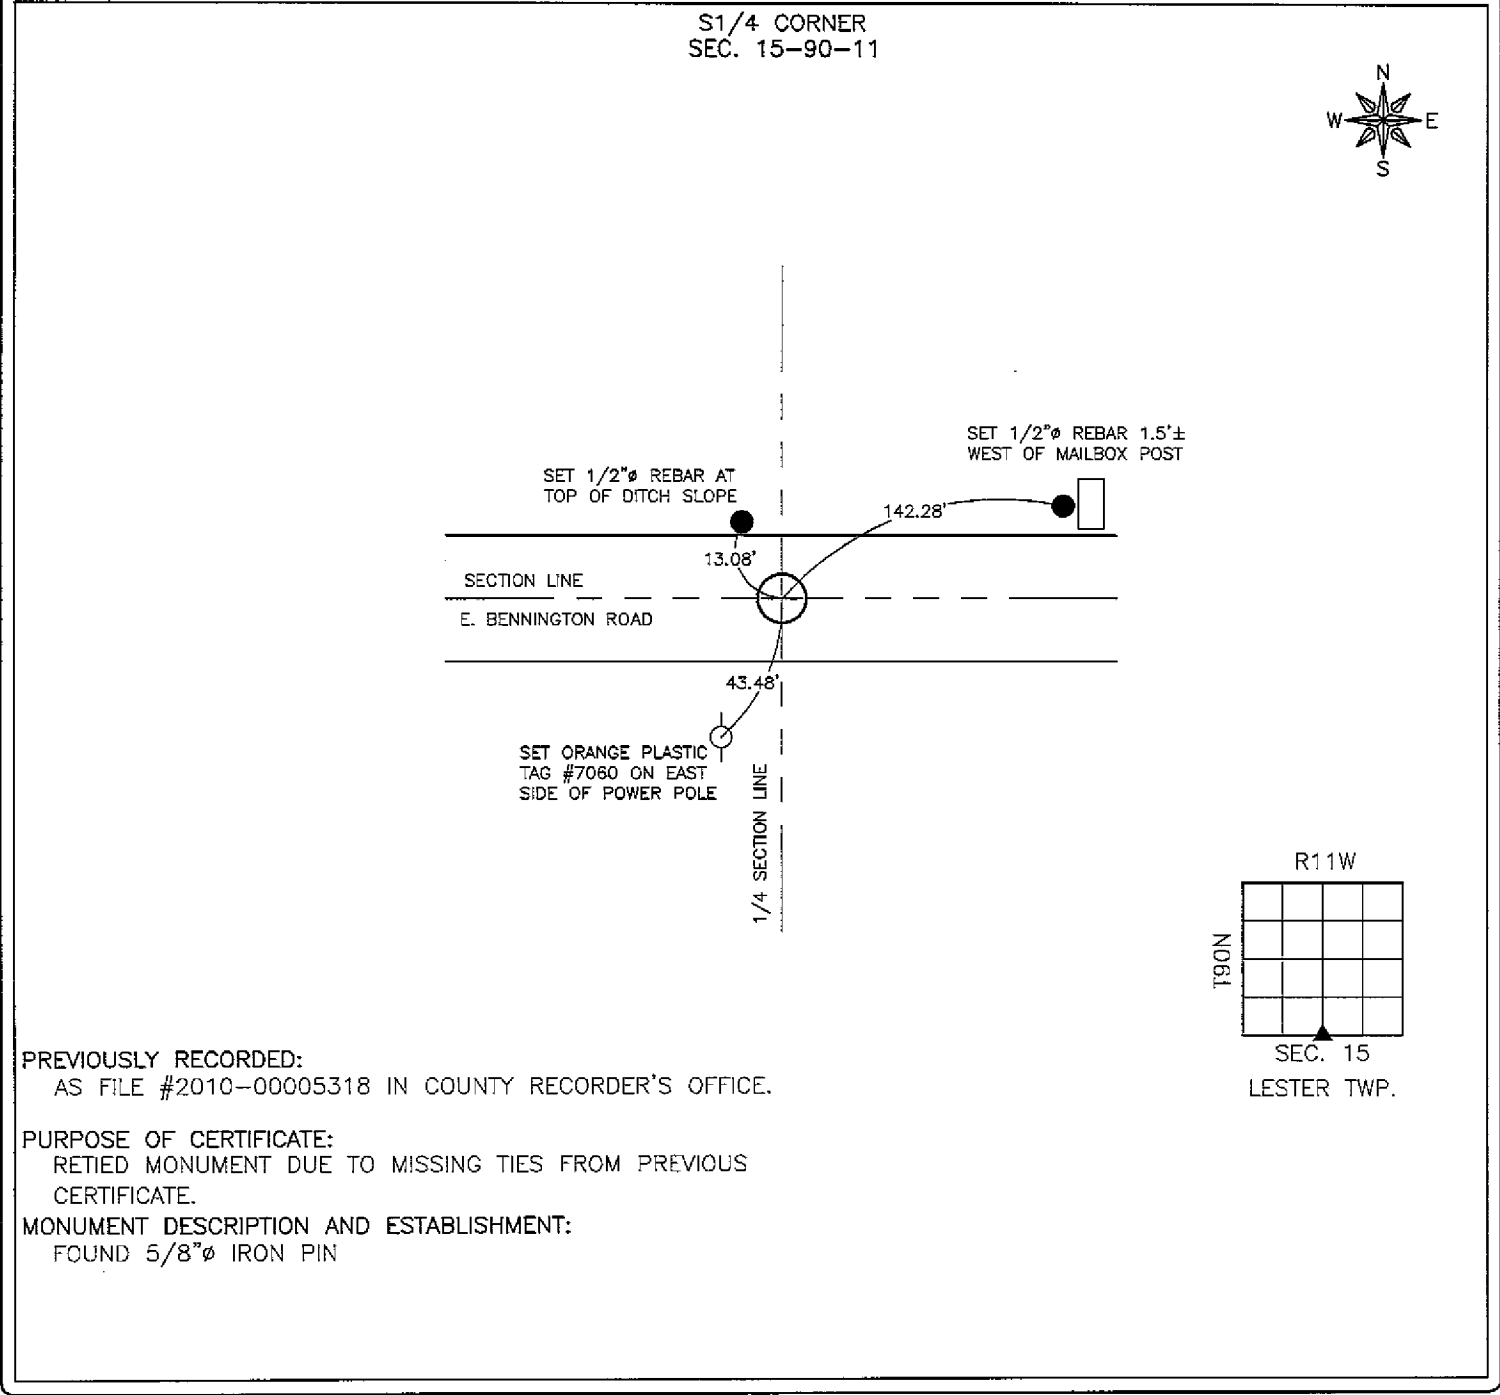

CORNERS TO BE INDEXED			
CORNER	SECTION	TOWNSHIP	RANGE
S1/4	15	90N	11W

I hereby certify that this land surveying document was prepared and the related survey work was performed by me or under my direct personal supervision and that I am a duly licensed Land Surveyor under the laws of the State of Iowa.

Lyle G. TeKippe 11-27-19
Lyle G. TeKippe, P.E. & P.L.S. Date
License Number: 7060
My license renewal date is December 31, 2020.
Sheets covered by this seal: SHEET 1

ENGINEERING & ENVIRONMENTAL
©2019 FEHR GRAHAM

ILLINOIS
IOWA
WISCONSIN

G:\C3D\19-914-LS-VAN DAELE\15-90-11W.dwg

JOB NUMBER:
19-914

SHEET NUMBER:
1 of 1