


Number: 202000009888
Recorded: 11/27/2019 at 12:49:06.0 PM
County Recording Fee: \$7.00
Iowa E-Filing Fee: \$3.13
Combined Fee: \$10.13
Revenue Tax:
Sandie L. Smith, RECORDER
Black Hawk County, Iowa

Prepared by/Return to: FEHR GRAHAM, 128 S. Vine Street, West Union IA 52175 – Ph: (563)422-5131

UNITED STATES PUBLIC LAND SURVEY CORNER CERTIFICATE
BLACK HAWK COUNTY, IOWA
SECTION 15-T90N-R11W

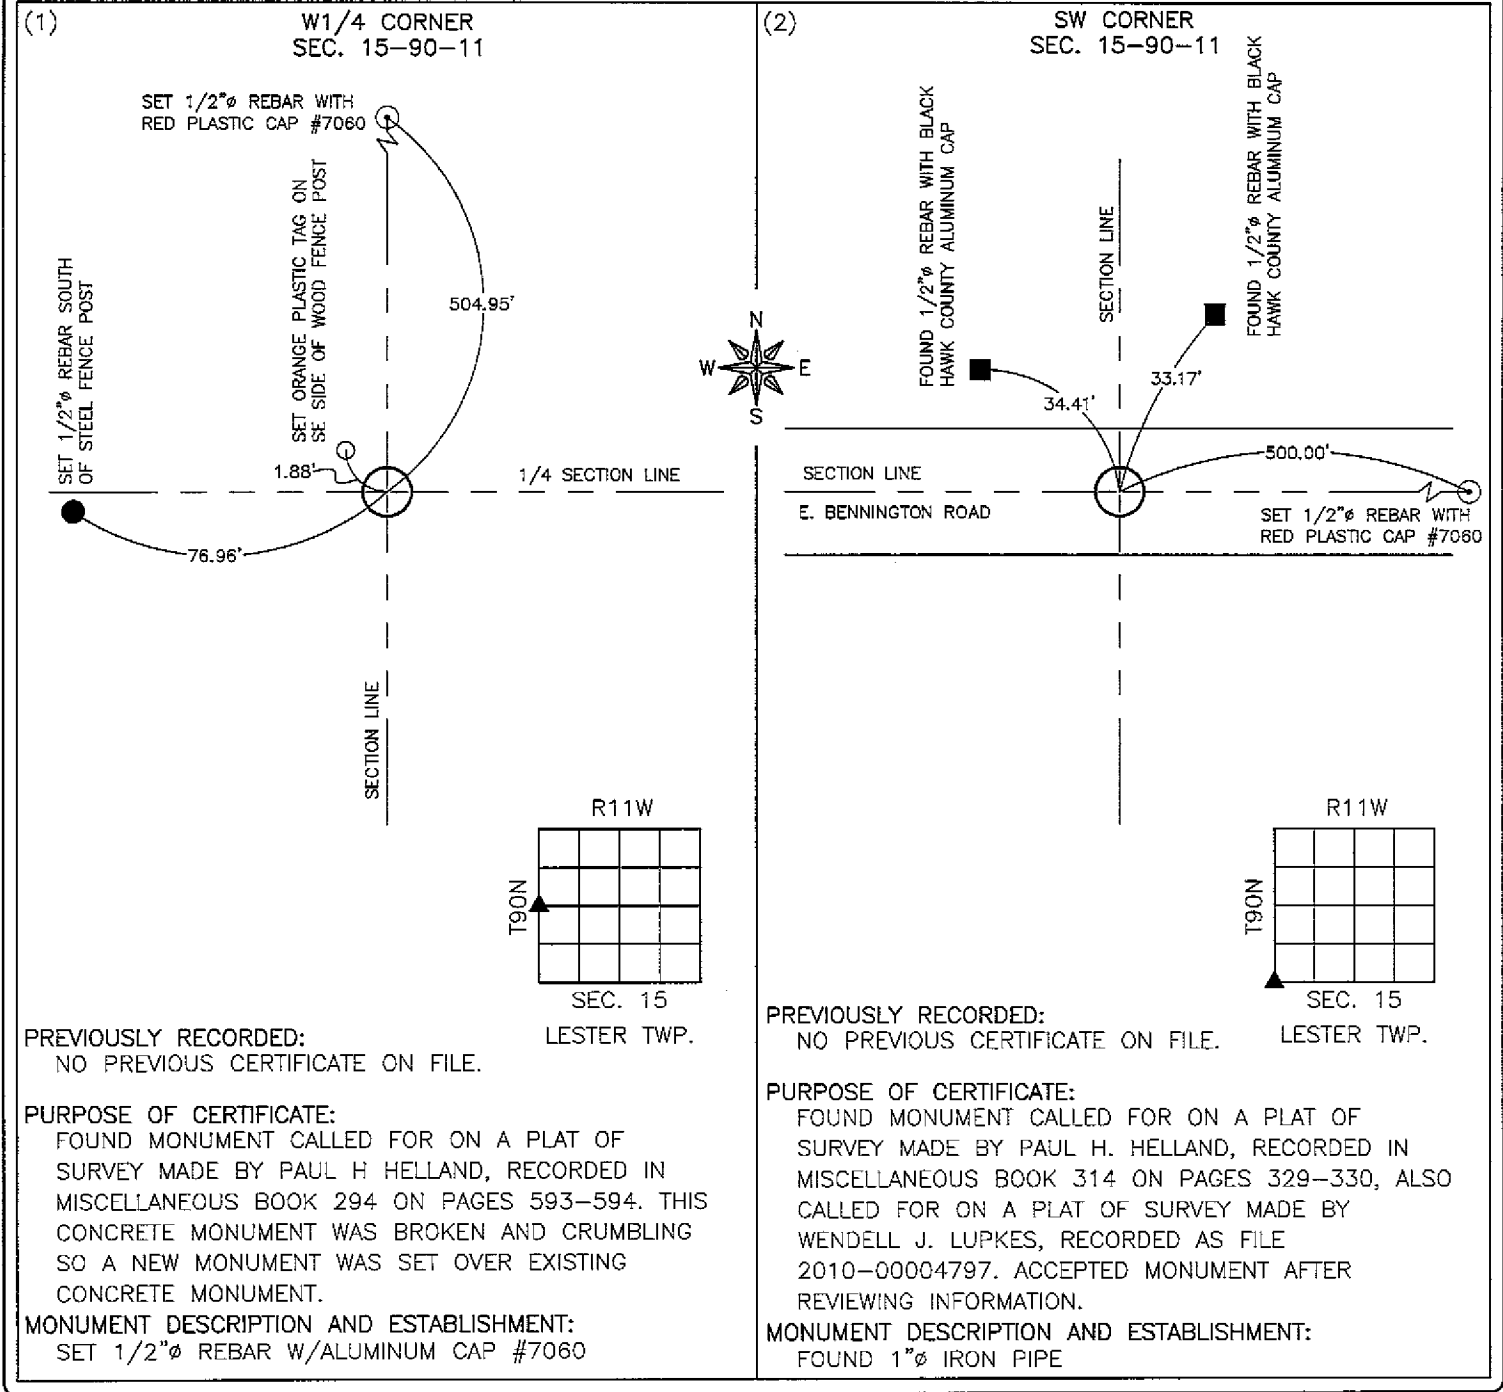

CORNERS TO BE INDEXED			
	CORNER	SECTION	TOWNSHIP RANGE
(1)	W1/4	15	90N 11W
(2)	SW	15	90N 11W

PROF. ENGINEER & LAND SURVEYOR

LYLE G. TEKIPPE

7060

IOWA

I hereby certify that this land surveying document was prepared and the related survey work was performed by me or under my direct personal supervision and that I am a duly licensed Land Surveyor under the laws of the State of Iowa.

Lyle G. Tekippe 11-27-19
Lyle G. Tekippe, P.E. & P.L.S. Date
License Number: 7060
My license renewal date is December 31, 2020.
Sheets covered by this seal: SHEET 1

FEHR GRAHAM

ENGINEERING & ENVIRONMENTAL

© 2019 FEHR GRAHAM

ILLINOIS
IOWA
WISCONSIN

G:\C3D\19\19-914-LS-VAN DAEL\15-90-11KU.dwg

JOB NUMBER:
19-914

SHEET NUMBER:
1 of 1

File Number: 2020-00009888 Seq: 1