



Doc ID: 005387060001 Type: GEN  
Kind: CORNER  
Recorded: 01/22/2014 at 01:05:30 PM  
Fee Amt: \$0.00 Page 1 of 1  
Black Hawk County Iowa  
JUDITH A MCCARTHY RECORDER

File 2014-00014134

PREPARED BY: BLACK HAWK COUNTY ENGINEERS OFFICE  
316 E. FIFTH STREET, ROOM 211 WATERLOO, IOWA 50703

PH.# (319) 833-3008  
FAX# (319) 833-3139  
SLSI 9-94  
BHCO 03-09

UNITED STATES PUBLIC LAND SURVEY CORNER CERTIFICATE OF  
Land Survey Monuments situated in Section 16, Township 90 N,  
Range 11 W, of the Fifth Principal Meridian, BLACK HAWK County, Iowa.  
Previously recorded in Misc. Book 346, Page 228, in County Recorder's Office.

(Show reason for preparing this certificate): The corner monument has been Replaced or Modified, per Ia. Code 355.11(1)(c)

(Evidence and detailed procedures used in establishing the corner position(s) and monumentation found or placed.)

Monument Description and Remarks: N.E. COR.  
CORNER RESET & TIES UPDATED PER PAVEMENT WIDENING AND H.M.A. RESURF. PROJECT  
LFM-1601--7X-07. PRIOR TO RESURF. PROJECT, FOUND 1/2" (#4) REBAR PER CURRENT  
RECORD AND TEMP. REF. COR. LOCATION PER RTK GPS. AFTER 6" P.C.C. CRACK & SEAL,  
SOUNDING REMAINED @ ± RTK REFERENCE LOCATION w/ NO FURTHER EXCAVATION. PVMT.  
RESURFACED w/ +5" (3.5" BASE & 1.5" SURF.) H.M.A. PAVING. AFTER H.M.A. RESURFACE,  
RESET CORNER WITH 6"L. MAG SPIKE w/ MTL. WASHER (PLS #15748) LOCATED @ ±0.10'  
SOUTH OF H.M.A. JOINT AND ALIGNED WITH REMNANT FENCELINE TO SOUTH.

### PLAN VIEW

"NOT TO SCALE"



BHco Hist. Ties: BK. #1003 p.16 T90-R11

FIELD BOOK: Ties per Topcon 7003i #Z0115

(Show a minimum of three reference ties to durable physical objects, relevant monuments and physical conditions that will enable recovery of the corner.)

- 1.) TIES PER EDM MEASURE IN EITHER PRISM "OR" NON-PRISM MODE, WHILE UTILIZING "INDIRECT" MEASURE, WITH ALL DISTANCES PLUMB/HORIZ. (HD), UNLESS DENOTED.
- 2.) SECTION LINE MEASURE REFERS TO "LOCAL GROUND" DIST. AND INCLUDES ELLIPSOIDAL (COMBINED) SCALE FACTOR FROM S.P.C. GRID INVERSE (AS OBSERVED, PER AVG. SCALE FACTOR = 1.000097098292)

-AG. CROPS-

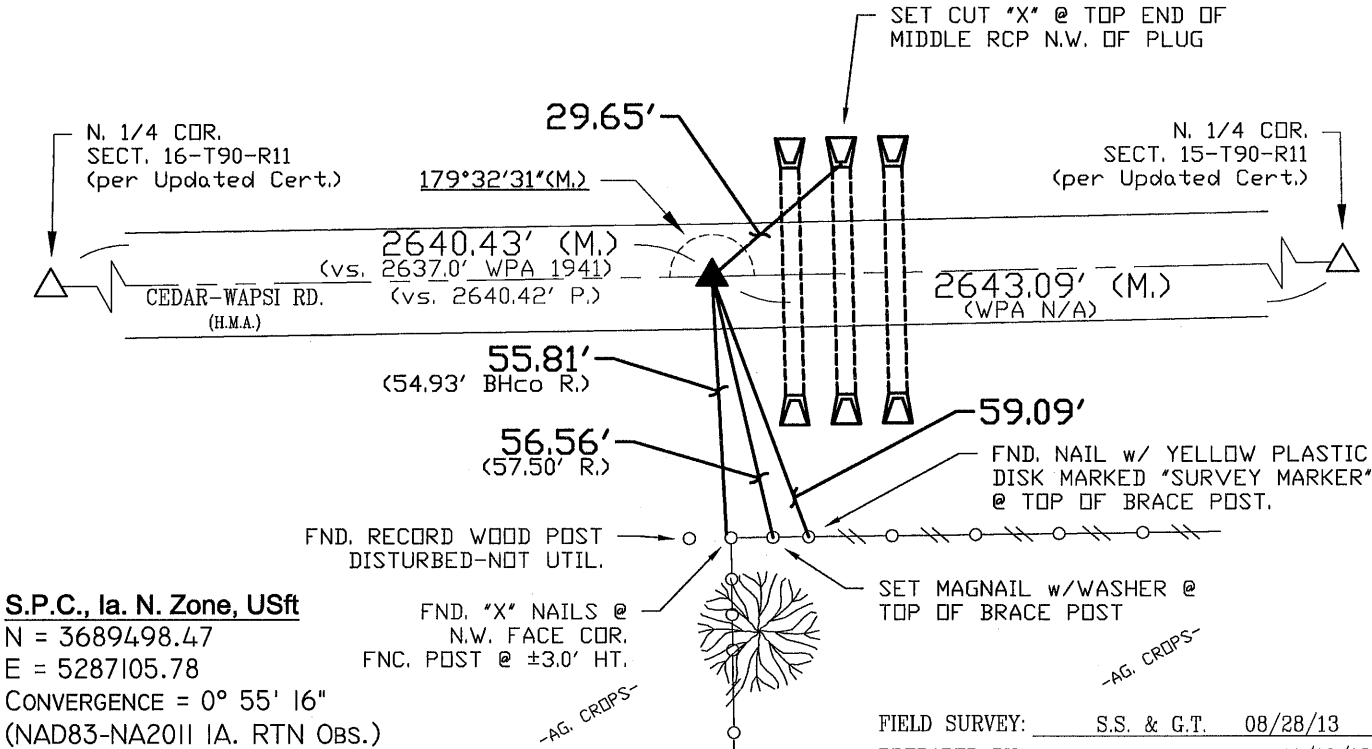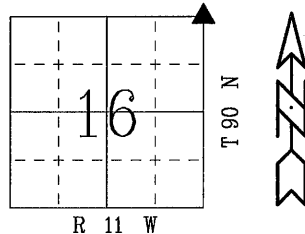

#### S.P.C., Ia. N. Zone, USft

N = 3689498.47

E = 5287105.78

CONVERGENCE = 0° 55' 16"

(NAD83-NA2011 IA. RTN OBS.)

### CERTIFICATION

I hereby certify that this land surveying document was prepared and the related survey work was performed by me or under my direct personal supervision and that I am a duly licensed Land Surveyor under the laws of the State of Iowa.

*Geoffry Allen Tinker* 01/22/2014  
Geoffry Allen Tinker (date)

License Number 15748

My license renewal date is December 31, 2014

Pages or sheets covered by this seal:

This Land Corner Certificate Only.

### LIST CORNERS TO BE INDEXED

Corner	Section	Township	Range
N.E. Cor.	16	90 N	11 W
N.W. Cor.	15	90 N	11 W
S.E. Cor.	9	90 N	11 W
S.W. Cor.	10	90 N	11 W

### INDEX OF ABBREVIATIONS

(M) = "Measured" Dimension  
(P) = "Platted" Dimension  
(R) = "Record" Dimension  
(C) = "Calculated" Dimension  
(IGS) = Iowa Geodetic Survey  
(WPA) = Works Progress Admin. Survey  
(G) = per George Miller Survey (BHco Surveyor 1858-1860)  
(B) = per John Ball Survey (BHco Surveyor 1866-1891)  
(N) = per Nathan Barber Survey (BHco Surveyor 1908-1931)  
(NP) = Reflectorless EDM Meas.  
(IM) = Indirect Measure  
(CM) = Concrete Monument  
(SM) = Survey Marker Spike/Tag  
(PK) = PK/MAG Nail Brand Style