

PREPARED BY: BLACK HAWK COUNTY ENGINEERS OFFICE
316 E. FIFTH STREET, ROOM 211 WATERLOO, IOWA 50703

PH.# (319) 833-3008
FAX.# (319) 833-3139
SLSI 9-94
BHCO 03-09

UNITED STATES PUBLIC LAND SURVEY CORNER CERTIFICATE OF
Land Survey Monuments situated in Section 17, Township 90 N,
Range 11 W, of the Fifth Principal Meridian, BLACK HAWK County, Iowa.
Previously recorded in FILE Book 2008, Page 14996, in County Recorder's Office.

(Show reason for preparing this certificate): The corner monument has been Replaced or Modified, per Ia. Code 355.11(1)(c)

(Evidence and detailed procedures used in establishing the corner position(s) and monumentation found or placed.)

Monument Description and Remarks: N. 1/4 COR.

CORNER ALSO ORIG. RECORDED IN FEE BOOK 2003-23869 DTD. FEB. 18th, 2003.
CORNER RESET & TIES UPDATED FOR H.M.A. RESURF. PROJECT LFM-1307--7X-07.
PRIOR TO RESURF. PROJECT, FOUND 1/2" (#4) REBAR PER CURRENT RECORD AND TEMP.
REF. COR. LOCATION PER RTK GPS (IaRTN). AFTER 2" DP. MILL, NO SOUNDING REMAINED
@ ± RTK REFERENCE LOCATION, w/ NO FURTHER EXCAVATION. PVMNT. RESURFACED w/
+3.5" (2" INT. & 1.5" SURF.) H.M.A. PAVING. AFTER H.M.A. RESURFACE, RESET CORNER WITH
6" L. MAG SPIKE w/ MTL. WASHER (PLS #15748) LOCATED @ ±0.60' SOUTH OF H.M.A. JOINT
AND ALIGNED WITH REMNANT FENCE (<"C" CHANNEL CORNER POST) TO SOUTH.

Project Point #: 1010

PLAN VIEW


"NOT TO SCALE"

BHco Hist. Ties: BK. #1003 p.17 90-11

FIELD BOOK: Ties per Topcon 7003i #Z0115

(Show a minimum of three reference ties to durable physical objects, relevant monuments and physical conditions that will enable recovery of the corner.)

- 1.) TIES PER EDM MEASURE IN EITHER PRISM "OR" NON-PRISM MODE, WHILE UTILIZING "INDIRECT" MEASURE, WITH ALL DISTANCES PLUMB/HORIZ. (H.D), AS DENOTED.
- 2.) SECTION LINE MEASURE REFERS TO "LOCAL GROUND" DIST. AND INCLUDES ELLIPSOIDAL (COMBINED) SCALE FACTOR FROM S.P.C. GRID INVERSE (AS OBSERVED), PER AVG. SCALE FACTOR = 1.000097017623

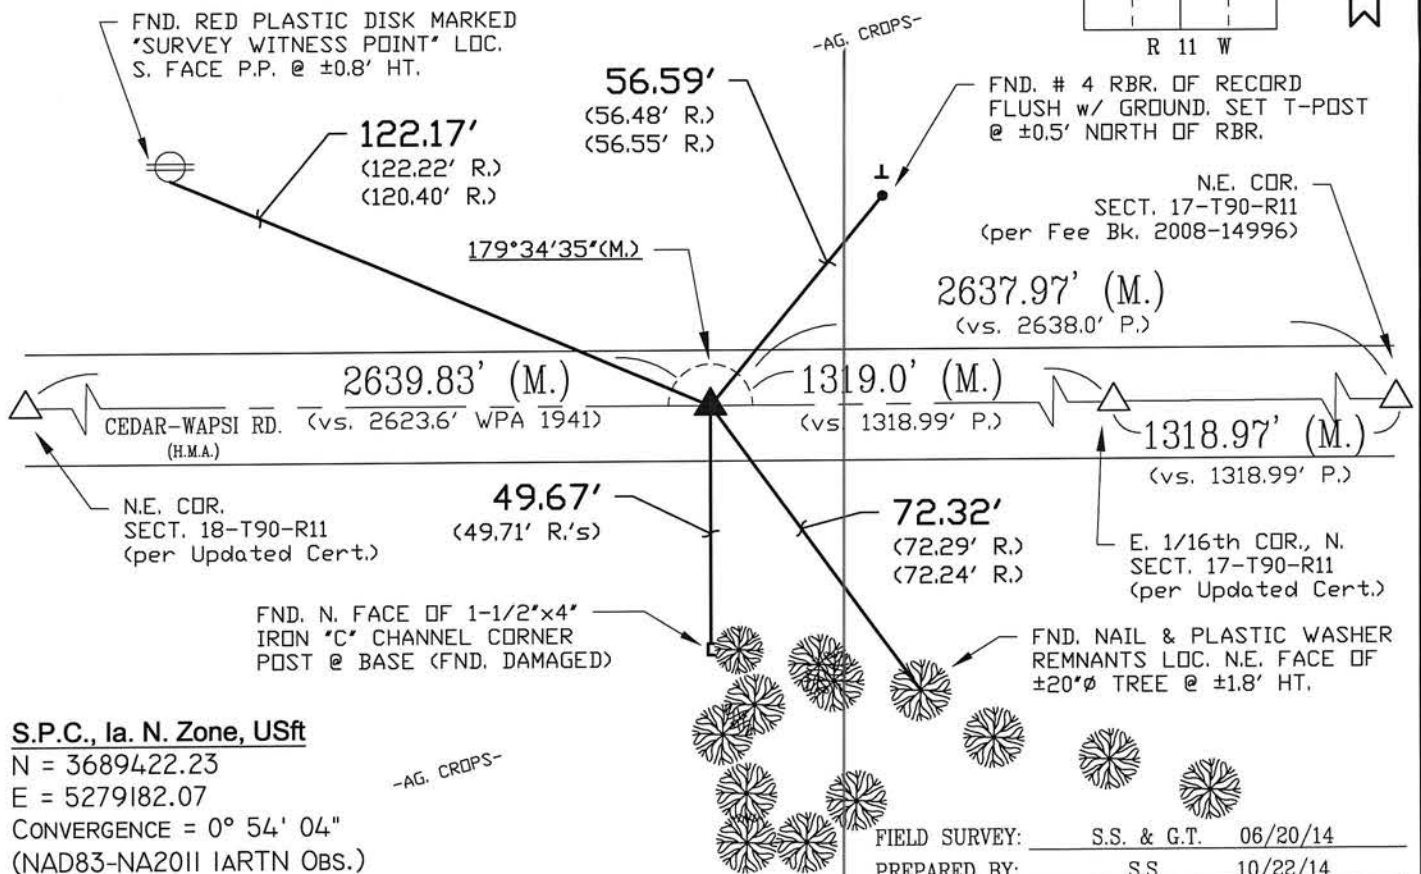

S.P.C., Ia. N. Zone, USft
N = 3689422.23
E = 5279182.07
CONVERGENCE = 0° 54' 04"
(NAD83-NA2011 IARTN OBS.)

CERTIFICATION

I hereby certify that this land surveying document was prepared and the related survey work was performed by me or under my direct personal supervision and that I am a duly licensed Land Surveyor under the laws of the State of Iowa.

Geoffrey Allen Tinker 10/22/2014
Geoffrey Allen Tinker (date)

License Number 15748

My license renewal date is December 31, 2014

Pages or sheets covered by this seal:

This Land Corner Certificate Only.

LIST CORNERS TO BE INDEXED

Corner	Section -	Township -	Range
N. 1/4 Cor.	17	90 N	11 W
S. 1/4 Cor.	8	90 N	11 W

INDEX OF ABBREVIATIONS

(M) = "Measured" Dimension	"NP" = Reflectorless EDM Meas.
(P) = "Platted" Dimension	"MIM" = Indirect Measure
(R) = "Record" Dimension	"CM" = Concrete Monument
(C) = "Calculated" Dimension	"SM" = Survey Marker Spike/Tag
"IGS" = Iowa Geodetic Survey	"PK" = PK/MAG Nail Brand Style
"WPA" = Works Progress Admin. Survey	
"G" = per George Miller Survey (BHco Surveyor 1858-1860)	
"B" = per John Ball Survey (BHco Surveyor 1866-1891)	
"N" = per Nathan Barber Survey (BHco Surveyor 1908-1931)	