



Doc ID: 004190380001 Type: GEN  
Kind: CORNER  
Recorded: 07/06/2010 at 10:52:24 AM  
Fee Amt: \$9.00 Page 1 of 1  
Black Hawk County Iowa  
JUDITH A MCCARTHY RECORDER  
File **2011-00000234**

Jeffrey P. Helland, 1107 Technology Parkway, Cedar Falls, Iowa 50613-6951, (319)-266-0161

## UNITED STATES PUBLIC LAND SURVEY CORNER CERTIFICATE OF

LAND SURVEY MONUMENTS SITUATED IN SECTION NO. 18, TOWNSHIP NO. 90 NORTH, RANGE  
NO. 11 WEST OF THE FIFTH PRINCIPAL MERIDIAN, BLACK HAWK COUNTY, IOWA.  
PREVIOUSLY RECORDED IN N/A

(SHOW REASON FOR PREPARING THIS CERTIFICATE, THE EVIDENCE AND DETAILED PROCEDURES USED IN ESTABLISHING THE  
CORNER POSITIONS AND MONUMENTATION FOUND OR PLACED.)


### MONUMENT DESCRIPTION AND REMARKS:

NO PREVIOUS REFERENCE TIES AVAILABLE. SURVEY COMPLETED IN THE SE 1/4 OF SEC. 18-T90N-R11W.

→ NE CORNER OF SE 1/4 SW 1/4: NO BLACK HAWK COUNTY ENGINEER TIES AVAILABLE. SET NO. 4 REBAR w/ALUMINUM CAP  
#16264 ON A STRAIGHT LINE BETWEEN THE N 1/4 CORNER AND THE S 1/4 CORNER OF SECTION 18 AND AT A BEST FIT  
ANALYSIS OF THE PRORATED DISTANCE FROM AUDITOR'S SURVEY RECORD BOOK 1 PAGE 225 DATED 7/27/1867 AND  
EXTENSION OF FENCE FROM THE EAST.


### PLAN VIEW

(SHOW A MINIMUM OF THREE REFERENCE TIES TO DURABLE PHYSICAL OBJECTS, RELEVANT MONUMENTS AND PHYSICAL  
CONDITIONS THAT WILL ENABLE RECOVERY OF THE CORNER.)

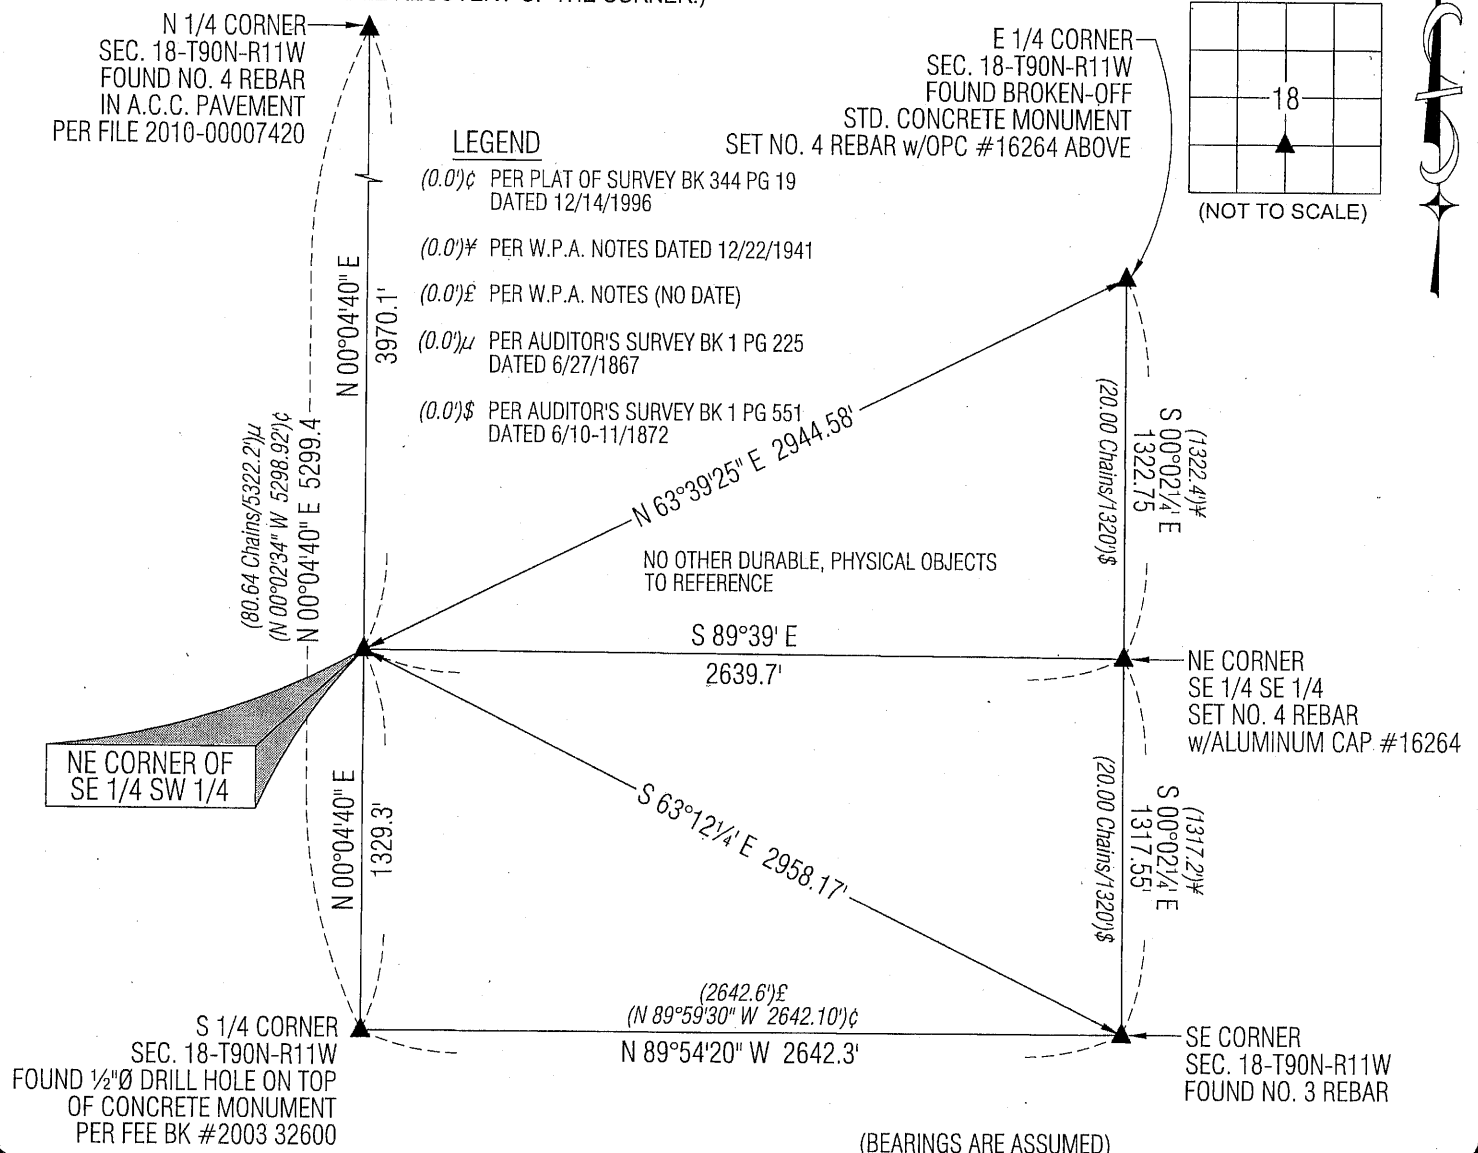

**HELLAND ENGINEERING & SURVEYING, LTD.**  
1107 Technology Parkway  
Cedar Falls, Iowa 50613-6951  
(319)-266-0161

SHINER = 8D NAIL & 1 5/16"Ø METAL SHINER  
BRASS TAG = 8D NAIL & 13/16"Ø BRASS TAG  
OPC = PLASTIC CAP (O=ORANGE, R=RED, Y=YELLOW)  
(00) RECORDED AS FILE NAME: 10-169C4.DWG

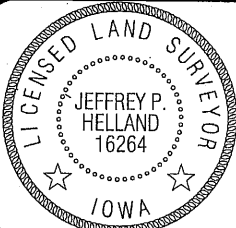

I hereby certify that this land surveying document was prepared  
and the related survey work was performed by me or under my  
direct personal supervision and that I am a duly licensed Land  
Surveyor under the laws of the State of Iowa.

*Jeffrey P. Helland 6/30/10*  
Jeffrey P. Helland  
License Number 16264  
My license renewal date is December 31, 2011.  
All pages or sheets are covered by this seal except:

### LIST CORNERS TO BE INDEXED

CORNER	SECTION	TOWNSHIP	RANGE
NE COR. SE 1/4 SW 1/4	18	90N	11W
SE COR. NE 1/4 SW 1/4	18	90N	11W
SW COR. NW 1/4 SE 1/4	17	90N	11W
NW COR. SW 1/4 SE 1/4	17	90N	11W

7.00

Rec.