INDEX BLACK HAWK COUNTY, IOWA:ss

FEE BOOK # 2005 21071

PROOF

FILED FOR RECORD MAR 14

<u>, 2005</u>, AT <u>4:00 P.</u>M.

FEE 1=5.00=1.00/


COMPARED

BLACK HAWK COUNTY RECORDER


KESS & ASSOCIATES

Kirk D. Eschliman, P.L.S. Iowa Lic. No. 9961, 723 Broadway Street, Waterloo, Iowa 50703 - Phone: 319-234-0509

UNITED STATES PUBLIC LAND SURVEY CORNER CERTIFICATE OF LAND SURVEY MONUMENTS SITUATED IN SECTION NINETEEN (19) , TOWNSHIP <u>NINETY (90) NORTH</u> RANGE <u>ELEVEN (11) WEST</u>, OF THE FIFTH PRINCIPAL MERIDIAN, BLACK HAWK PREVIOUSLY RECORDED IN (NOT PREVIOUSLY RECORDED) (BOOK, PAGE, DOCUMENT NUMBER, ETC.) IN THE COUNTY RECORDER'S OFFICE. (SHOW REASON FOR PREPARING THIS CERTIFICATE, THE EVIDENCE AND DETAILED PROCEDURES USED IN ESTABLISHING THE CORNER POSITIONS AND MONUMENTATION FOUND OR PLACED.) MONUMENT DESCRIPTION AND REMARKS: CURRENT SECTION CORNER CERTIFICATE NOT ON FILE IN THE BLACK HAWK COUNTY ENGINEER'S OFFICE. FOUND DAMAGED AND LEANING CONCRETE W.P.A. MONUMENT (MISSING TOP & PURPOSELY SHORTENED) RESTING ATOP A SHAPED GRANITE STONE WITH A 30 INCH NO. 5 REBAR (PER 1939 NOTES), (REBAR BENT WLY) ALONG NLY SIDE, NW OF ROADWAY ALONG SWLY SIDE OF FIELD ACCESS, 12 INCHES BELOW GRASSED SURFACE REPLACED ALL WITH A 30 INCH NO. 4 REBAR W/FLAGGING AND YELLOW ID. CAP "IOWA - 9961" R12W PLAN VIEW T90N, T90N, NE 1/4, SEC. 25 NW 1/4, SEC. 19 SET NO. 4 REBAR W/YELL. ID. CAP, "IOWA - 9961" EAST LINE, WEST LINE, T90N, R12W T90N, R11W AT INTERSECTION OF R.O.W. SET NO. 4 REBAR W/YELL. ID. CAP, "IOWA — 9961" OF WEST SEC. LINE 33.0 FT. EDGE OF PUBLIC RIGHT OF WAY AT INTERSECTION OF R.O.W.S STREET SIGN C.M.P. CULVERT (NE TO SW FLOW) EDGE OF GRANULAR SURFACE LESTER ROAD FIELD DRIVE SET NO. 4 REBAR W/YELL. CENTERLINE 66 FT. PUBLIC R.O.W. on EIGE OF GRANUAR 33.0 FT. ID. CAP, "IOWA - 9961" ON WESTERLY EXTENSION OF CENTER SEC. LINE AT INTERSECTION OF R.O.W. GRANULAR SURFACED ROAD R.0. BLIC SW 1/4, SEC. 19 T90N, R11W 10.0′ | 9.2′ EDGE OF PUBLIC RIGHT OF WAY SE 1/4, SEC. 25 99 R12W R11W SEE NOTES ABOVE T90N, R12W 능 SET NO. 4 REBAR W/YELL. ID. CAP, "IOWA — 9961" 0.5 FEET DEEP T90N, T90N, PUBLIC | H. I. H. Ξ SW CORNER, NW 1/4 ALL MEASUREMENTS 99 TO FACE OF OBJECTS (WEST 1/4 CORNER) 등

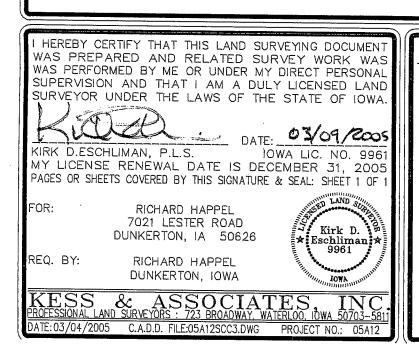

NOT TO SCALE

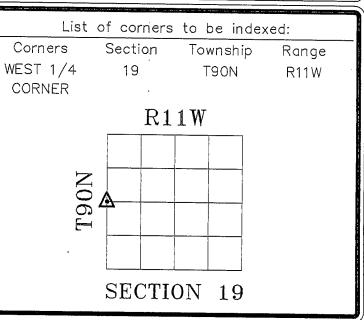

SEC. 19, T90N, R11W

BLACK HAWK COUNTY, IOWA