Doc ID: 004264510001 Type: GEN Kind: CORNER


File 2011-00005901


PREPARED BY


STEPHEN MICHAEL BRAIN, BRAIN ENGINEERING, INC., 1540 MIDLAND COURT NE, CEDAR RAPIDS, IOWA PH. (319) 294-9424

STATES PUBLIC UNITED LAND SURVEY CORNER CERTIFICATE

LAND SURVEY MONUMENTS SITUATED IN SECTION 22 , TOWNSHIP 90 NORTH RANGE __11 WEST OF THE 5TH P.M., _____BLACK HAWK _____ COUNTY, IOWA.

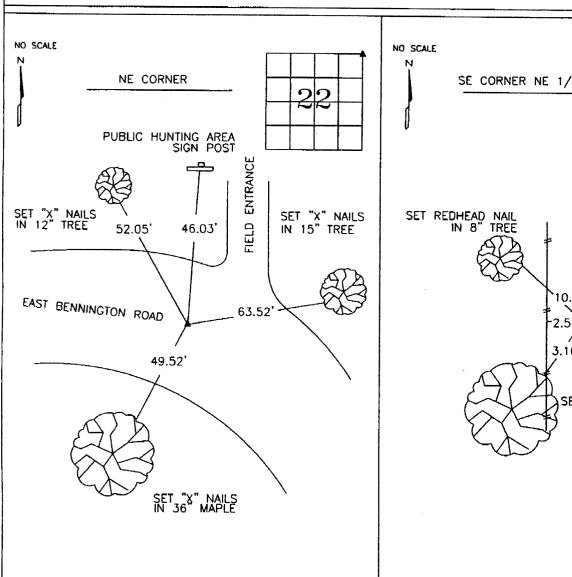

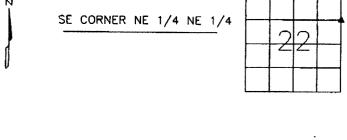


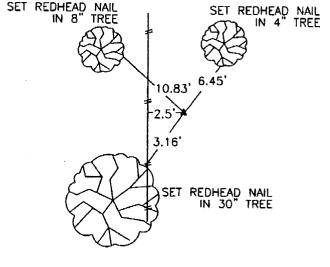

PREVIOUSLY RECORDED IN BOOK _____ PAGE ____ MONUMENT DESCRIPTION AND HOW ESTABLISHED ___ FOUND SPIKE IN E. BENNINGTON RD LOCATION FIT COUNTY ENGINEER TIES AND CHAINING NOTES SET 1/2" REBAR YPC 9647 IN SAME LOCATION AFTER FURTHER SEARCHING

PREVIOUSLY RECORDED IN BOOK _____ PAGE ____ MONUMENT DESCRIPTION AND HOW ESTABLISHED SET 1/2" REBAR AT THE MIDPOINT OF THE LINE BETWEEN THE NE CORNER AND THE EAST 1/4 CORNER

FOR CONCRETE MONUMENT

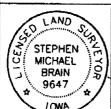

hereby certify that this land surveying document nd the related survey work was performed by me r under my direct personal supervision and that am a duly licensed Land Surveyor under the laws if the State of lawa.

Date Michael Brain, L.S.

Process Renewal Date is December 31, 2010

This seal: 1/1 9/21/10 My License Rene

License Number 9647
Pages or sheets covered by this seal: 1/1

CORNERS TO BE INDEXED CORNER **SECTION TOWNSHIP** RANGE NE CORNER 22 T90N R11W SE CORNER 22 T 90N R11W NE 1/4 NE 1/4

- ☑ A.THERE IS NO CERTIFICATE FOR THE CORNER ON FILE WITH THE RECORDER OF THE COUNTY IN WHICH THE CORNER IS LOCATED
- CORNER IS LOCATED

 B.THE SURVEYOR IN RESPONSIBLE CHARGE OF THE LAND SURVEYING ACCEPTS A CORNER POSITION WHICH DIFFERS FROM THAT SHOWN IN THE PUBLIC RECORDS OF THE COUNTY IN WHICH THE CORNER IS LOCATED.

 C.THE CORNER MONUMENT IS REPLACED OR MODIFIED IN ANY WAY.

 D.THE REFERENCE TIES REFERRED TO IN AN EXISTING PUBLIC RECORD ARE NOT CORRECT.

BRAIN ENGINEERING, INC. 1540 MIDLAND COURT NE CEDAR RAPIDS, IOWA 52402 406210-15 (319) 294-9424

9.00RS

D ~ ~ 1e