
Doc ID: 004264490001 Type: GEN Kind: CORNER Recorded: 09/24/2010 at 01:22:57 PM Fee Amt: \$9.00 Page 1 of 1 Black Hawk County Iowa JUDITH A MCCARTHY RECORDER

File 2011-00005899

PREPARED BY

STEPHEN MICHAEL BRAIN, BRAIN ENGINEERING, INC., 1540 MIDLAND COURT NE, CEDAR RAPIDS, IOWA PH. (319) 294-9424

STATES PUBLIC UNITED LAND SURVEY CORNER CERTIFICATE

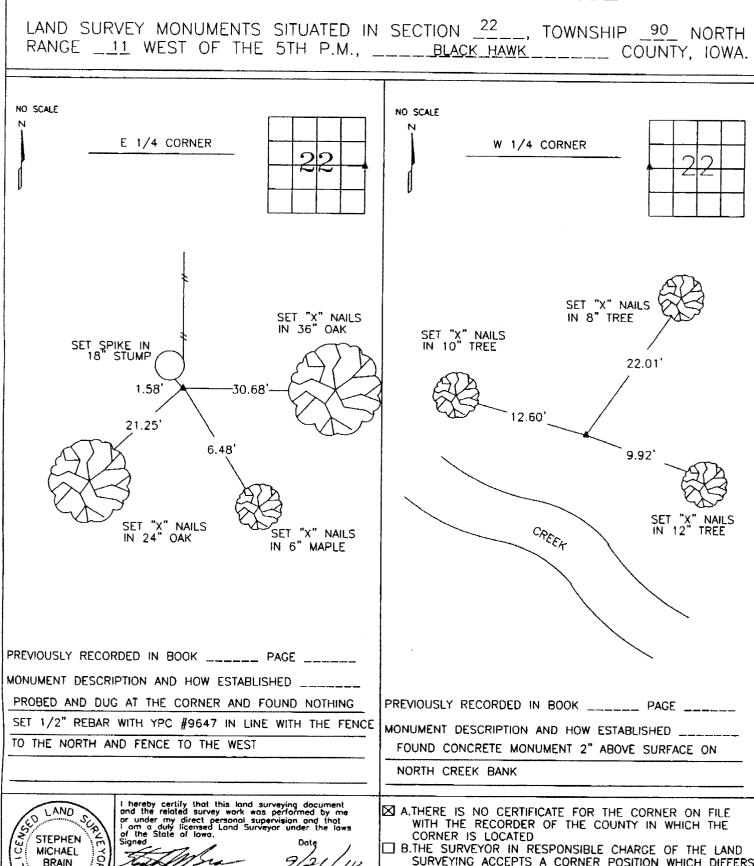



Brain, L.S. rol Date is December 31, 2010 n Michael Brain My License Renewal Date is December 31, a License Number 9647 Pages or sheets covered by this seal: 1/1

T90N

R11W

CORNERS TO BE INDEXED CORNER SECTION **TOWNSHIP** RANGE E 1/4 CORNER 22 T90N R11W

22

B.THE SURVEYOR IN RESPONSIBLE CHARGE OF THE LAND SURVEYING ACCEPTS A CORNER POSITION WHICH DIFFERS FROM THAT SHOWN IN THE PUBLIC RECORDS OF THE COUNTY IN WHICH THE CORNER IS LOCATED.

C.THE CORNER MONUMENT IS REPLACED OR MODIFIED IN

ANY WAY.

D.THE REFERENCE TIES REFERRED TO IN AN EXISTING PUBLIC RECORD ARE NOT CORRECT.

BRAIN ENGINEERING, INC. 1540 MIDLAND COURT NE CEDAR RAPIDS, IOWA 52402 406210 - 15(319) 294-9424

900 RS

W 1/4 CORNER