

UNITED STATES PUBLIC LAND SURVEY CORNER CERTIFICATE

OF

RECORDED

Land Survey Monuments situated in Section 23, Township 90N, Range 11W, of the Fifth Principal Meridian, BLACK HAWK County, Iowa.
Previously recorded in N/A in County Recorder's Office.


(book, page, document number, etc.)

(Show reason for preparing this certificate, the evidence and detailed procedures used in establishing the corner positions and monumentation found or placed.)

Monument Description and Remarks: DUG 4'x4'x3 1/2' HOLE, PROBED BOTTOM W/TILE PROD,
FOUND NOTHING AT WUPA (YOUNGERMAN) DIST. W. OF NE COR. SET 1/2" RE-BAR &
CAP IN LINE W/ N-S FENCE TO NO. 1 ON E-W LINE THROUGH NE COR & 53'
NO. OF CAP NO. 3862, 380'± EAST ON SO. SIDE ROAD. SURVEY RECORD MISC.
262-128 HAD CORNER AS "SPIKE" ONLY. DIST TO NE COR = 2662.6' (EDM), WUPA
NOTES CALLED 2664.5' CORNER. HILL ON WEST END THIS LINE.

PLAN - VIEW

(Show a minimum of three reference ties to durable physical objects, relevant monuments and physical conditions that will enable recovery of the corner.)

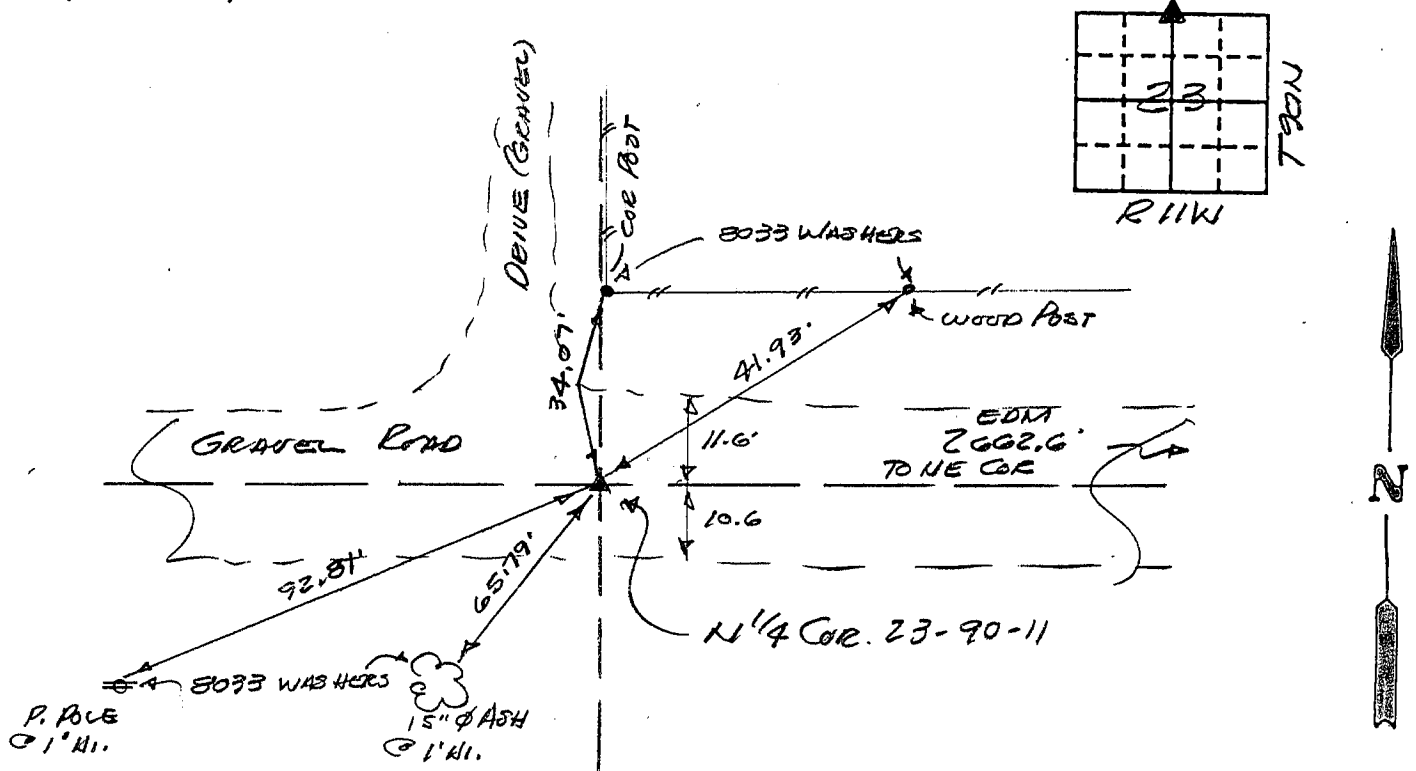

352-56

I hereby certify that the survey work was completed and this certificate was prepared by me or under my direct personal supervision and that I am a duly registered land surveyor under the laws of the state of Iowa.

Signature:

F. William King

Name typed or printed:

F. WILLIAM KING

Date:


6-16-1992

Reg. No.

8033

Corners	List Corners to be Indexed Section	Twp	Range
N 1/4	23	90N	11W

SEAL

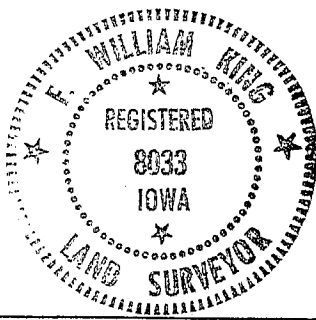

MISC. BK. 301 p. 684

