



Doc ID: 005099700001 Type: GEN
Kind: CORNER
Recorded: 03/27/2013 at 03:43:38 PM
Fee Amt: \$7.00 Page 1 of 1
Black Hawk County Iowa
JUDITH A MCCARTHY RECORDER
File **2013-00019850**

RETURN TO &

PREPARED BY: LEO P. BONIFAZI SCHNOOR-BONIFAZI ENGINEERING & SURVEYING LC, 2750 FIRST AVE. NE, STE. 110, CEDAR RAPIDS, IA 52402 319-298-8888

UNITED STATES PUBLIC LAND SURVEY CORNER CERTIFICATE

Land Survey Monuments Situated in Section 27, Township 90 North, Range 11 W of the Fifth Principal Meridian, BLACK HAWK County, Iowa.

Reason for filing: ☒ a. No certificate of record found. ☒ b. Monument or ties found differ from record. ☐ c. Replaced section corner.

NORTH 1/4 CORNER FOUND STANDARD CONCRETE MONUMENT WITH 1/2" IRON ROD ON NORTH SIDE FOR DETECTION.

(Prev. Recorded AS N. 1/4 said Section per MISC. Bk. 344 p. 900 (J.T.))



NORTHEAST CORNER FOUND IRON PIPE. MONUMENT IS IN LOGICAL LOCATION FOR NE CORNER OF SECTION. NO OTHER MONUMENTS ARE FOUND IN THE GENERAL VICINITY.

(Prev. Recorded AS N.E. Cor. said Section per FILE 2013-015777 (J.T.))

EAST 1/4 CORNER FOUND 1" PINCH PIPE 0.20' DEEP. MONUMENT IS LOCATED IN THE APPROXIMATE CENTER OF WHEELER ROAD ESTABLISHED AS A SECTION LINE ROAD.

(Prev. Recorded AS E. 1/4 said Section per FILE 2013-015778 (J.T.))

COORDINATES LISTED HEREON ARE NAD83 (1996) IOWA NORTH ZONE.

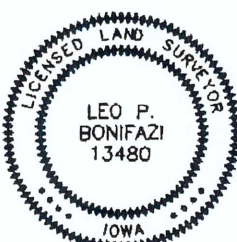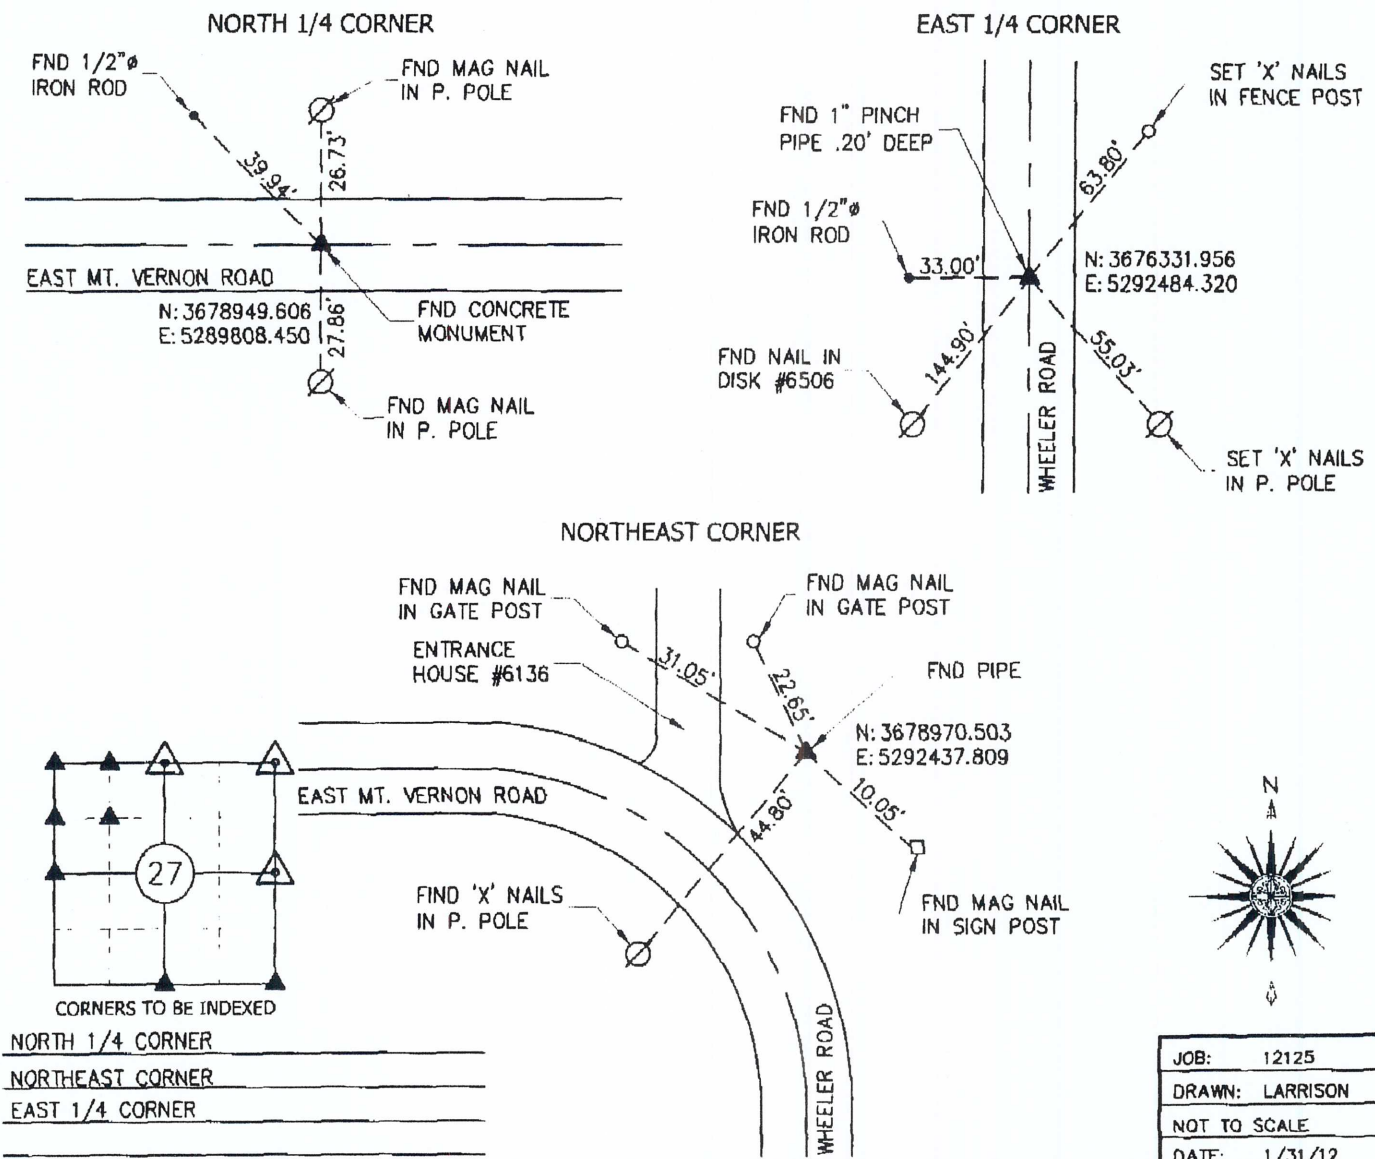

I HEREBY CERTIFY THAT THIS LAND SURVEYING DOCUMENT WAS PREPARED AND THE RELATED SURVEY WORK WAS PERFORMED BY ME OR UNDER MY DIRECT PERSONAL SUPERVISION AND THAT I AM A DULY LICENSED LAND SURVEYOR UNDER THE LAWS OF THE STATE OF IOWA.

SIGNATURE: *[Signature]*
LEO P. BONIFAZI
LICENSE NO. 13480
SHEETS COVERED BY THIS SET

DATE: **3-23-13**

THIS SHEET ONLY

MY LICENSE RENEWAL DATE IS DECEMBER 31, 2013

SCHNOOR-BONIFAZI
ENGINEERING & SURVEYING, LC
2750 FIRST AVE. NE, STE. 110
CEDAR RAPIDS, IA 52402
(319) 298-8888 (PHONE)
(319) 298-8889 (FAX)
s-b-engineering.com

