Doc ID: 003695240001 Type: GEN Recorded: 03/10/2009 at 08:46:05 AM Fee Amt: \$7.00 Page 1 of 1 Instr# 200800019726

Black Hawk County Iowa JUDITH A MCCARTHY RECORDER Book 1080 Page 22190 - 22190 File 2009-00016797

Jeffrey P. Helland, 1107 Technology Parkway, Cedar Falls, Iowa 50613-6951, (319)-266-0161

UNITED STATES PUBLIC LAND SURVEY CORNER CERTIFICATE OF.

LAND SURVEY MONUMENTS SITUATED IN SECTION NO. 90 _, TOWNSHIP NO._ NORTH, RANGE _WEST OF THE FIFTH PRINCIPAL MERIDIAN,_ **BLACK HAWK** COUNTY, IOWA.


PREVIOUSLY RECORDED IN 345 MISC 54

(SHOW REASON FOR PREPARING THIS CERTIFICATE, THE EVIDENCE AND DETAILED PROCEDURES USED IN ESTABLISHING THE CORNER POSITIONS AND MONUMENTATION FOUND OR PLACED.)

MONUMENT DESCRIPTION AND REMARKS:

345 MISC 54 REFERENCE TIES HAVE CHANGED. SURVEY COMPLETED IN THE NE 1/4 OF SEC. 29-T90N-R11W.

-E 1/4 CORNER: W.P.A. NOTES (NO DATE) CALLS FOR [DUG & FOUND NOTHING, ESTABLISHED CORNER 26+40' N. SE 29-90-11 26+40.3" S NE 29-90-11 26+68.25' FROM CENTER 29-90-11 26+38.45' FROM CENTER 28-90-11]. USPLSCC BK 333 MISC 276 DATED 2/1/1999 CALLS FOR [FOUND 2" DIA. BRASS CAP W/SMALL "X" IN CENTER, 2" BELOW A.C.C. SURFACE AS PER COUNTY TIES]. USPLSCC BK 345 MISC 54 DATED 12/11/2001 CALLS FOR [FOUND BRASS MARKER]. DUNKERTON LAGOON MINOR SUBDIVISION PLAT FEE BK #2003 11419 DATED 9/27/2002 CALLS FOR [FD REBAR IN PAVEMENT]. BRIDGE OVER RAILROAD WAS REMOVED AND ROAD LOWERED SUBSTANTIALLY. FOUND CUT "X" IN P.C.C. PAVEMENT 0.4' WEST OF CENTER! INF IOINT CENTERLINE JOINT. PLAN VIEW

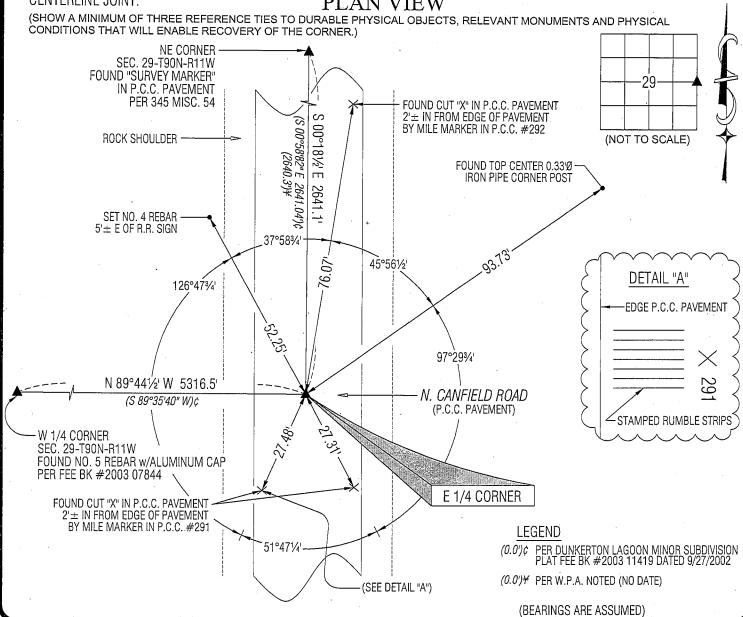

LAND

HELLAND 16264

4 W 0 \

HELLAND ENGINEERING & SURVEYING, LTD.

1107 Technology Parkway Cedar Falls, Iowa 50613-6951

(319)-266-0161

I hereby certify that this land surveying document was prepared and the related survey work was performed by me or under my direct personal supervision and that I am a duly licensed Land Surveyor under the laws of the State of lowa. Villand 3/5/09

deffrey? Helland License Number 16264 My license renewal date is December 31, 2009. All pages or sheets are covered by this seal except:

SHINER = 8D NAIL & 1 5/16"Ø METAL SHINER BRASS TAG = 13/16"Ø BRASS TAG

OPC = PLASTIC CAP (O=ORANGE, R=RED, Y=YELLOW)
(00') RECORDED AS FILE NAME: 08-170C2.DWG

LIST CORNERS TO BE INDEXED		
SECTION	TOWNSHIP	RANGE
29	90N	11W
. , 28	90N	11W
	SECTION 29	SECTION TOWNSHIP 29 90N