Recorded: 04/10/2020 at 11:00:58 A Fee Amt: \$7.00 Page 1 of 1 Black Hawk County Iowa SANDIE I SMITH RECORDER

File 2020-00017508


ant \*

WAYNE CLAASSEN ENGINEERING AND SURVEYING, INC. P.O. BOX 898 WATERLOO, IOWA 50704-0898

PHONE: (VOICE) 319-235-6294 (FAX) 319-235-0028

## UNITED STATES PUBLIC LAND SURVEY CORNER CERTIFICATE

Land Survey Monuments  11 West ,	situated in Section _ of the Fifth Principal	,	Township Black Hawk	90 North , Range County, Iowa.			
Previously recorded in _	2013-	-15773	in County	Recorder's Office.			
Monument Description and Remarks							
Found spike nail as per above certificate.							

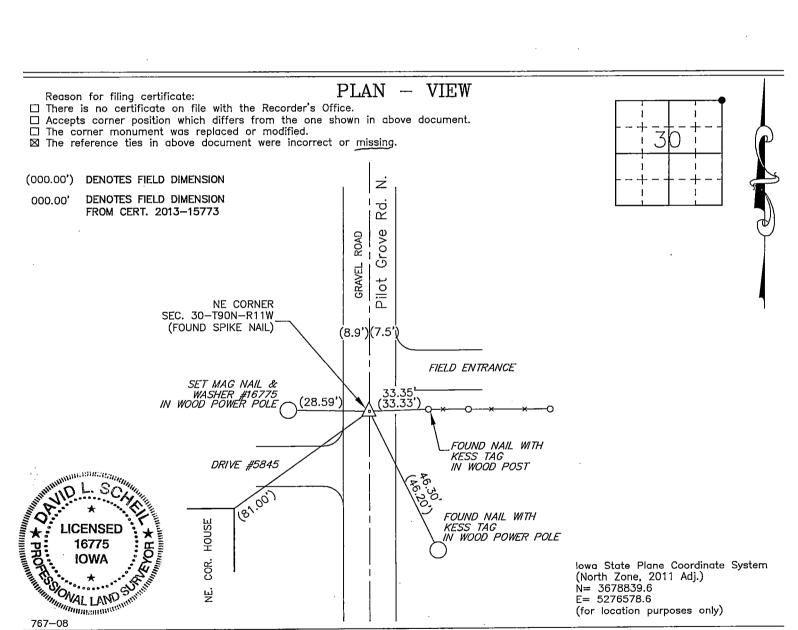

I hereby certify that this land surveying document was prepared and the related survey work was performed by me or under my direct personal supervision and that I am a duly Licensed Land Surveyor under the laws of the State of Iowa.

Signature:

David L. Scheil, L.S.

Date: APMIL 08, 7070 Lic. No. 16775

Pages or Sheets Covered by this Seal: THIS SHEET ONLY.

My license renewal date is December 31, 2020

SEAL

				_
List	Corners to b	e Indexed		-
Corners	Section	Twp	Range	
NE CORNER,	30	90 N	11 W	
SE CORNER,	19	90 N	11 W	
SW CORNER,	20	90 N	11 W	
NW CORNER,	29	90 N	11 W	

File Number: 2020-00017508 Seq: 1