



Doc ID: 004442740001 Type: GEN
Kind: CORNER
Recorded: 04/18/2011 at 08:32:03 AM
Fee Amt: \$9.00 Page 1 of 1
Black Hawk County Iowa
JUDITH A MCCARTHY RECORDER

File 2011-00019887




PREPARED BY: GREGG E. SAMPSON, AMENT, INC., 625 - 32ND AVENUE SW, CEDAR RAPIDS, IA 52404 (319) 378-1401

UNITED STATES PUBLIC LAND SURVEY CORNER CERTIFICATE
OF

Land Survey Monuments situated in Section 32 Township 90N Range
11 WEST of the Fifth Principal Meridian BLACK HAWK County, Iowa.
Previously recorded in BOOK 316 PAGE 241 in the County Recorder's Office.

Monument Description and Remarks: FOUND BRASS CAP IN PAVING PER CORNER CERTIFICATE
BOOK 316 PAGE 241. ONE RECORD REFERENCE TIE MISSING. REFILEING CERTIFICATE TO
REFLECT CURRENT CONDITIONS.

PLAN - VIEW

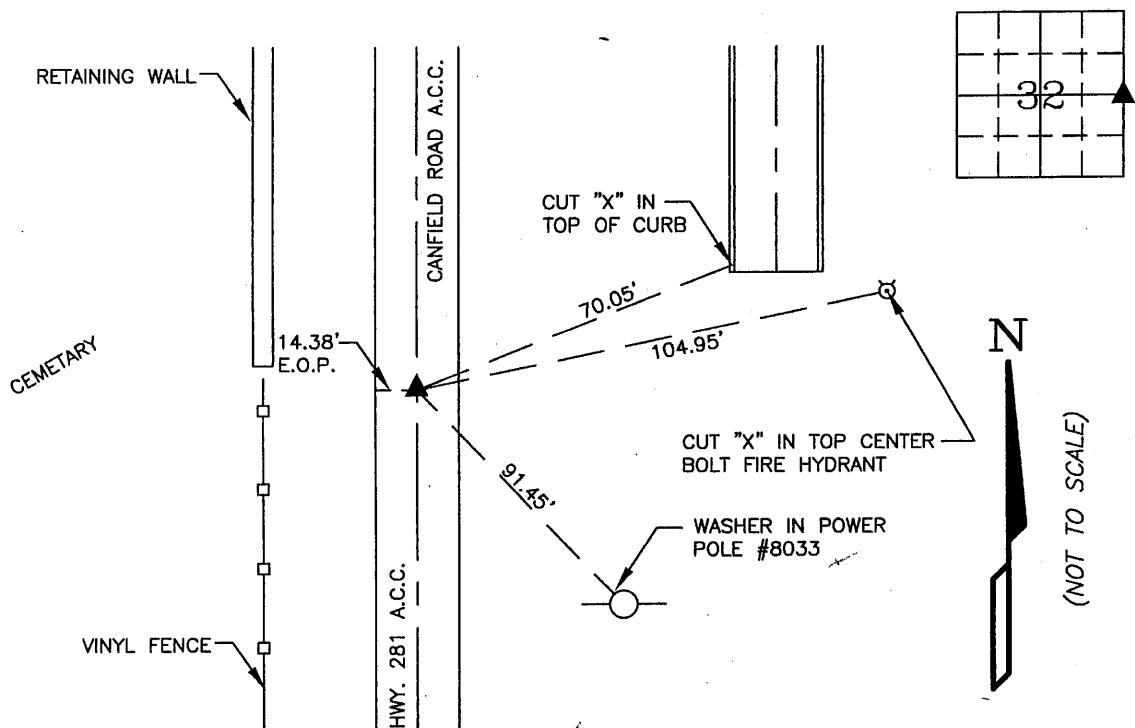

I hereby certify that the survey work was completed and this certificate was prepared by me or under my direct personal supervision and that I am a duly licensed land surveyor under the laws of the state of Iowa.

Signature: Gregg E. Sampson
Gregg E. Sampson, Iowa Licensed Land Surveyor No. 14809

Date: 6-2-2010 License renewal December 31, 2010

List Corners to be Indexed
Corners Section Twp Range
E 1/4 32 90N. 11W.

SEAL

