

PREPARED BY: BLACK HAWK COUNTY ENGINEERS OFFICE  
316 E. FIFTH STREET, ROOM 211 WATERLOO, IOWA 50703

PH.# (319) 833-3008  
FAX.# (319) 833-3139  
SLSI 9-94  
BHCO 03-09



UNITED STATES PUBLIC LAND SURVEY CORNER CERTIFICATE OF  
Land Survey Monuments situated in Section 32, Township 90 N, Range 11 W, of the Fifth Principal Meridian, BLACK HAWK County, Iowa.  
Previously recorded in Misc Book 331, Page 244, in County Recorder's Office.  
(Show reason for preparing this certificate): The corner monument has been Replaced or Modified, per Ia. Code 355.11(1)(c)  
(Evidence and detailed procedures used in establishing the corner position(s) and monumentation found or placed.)  
Monument Description and Remarks: N. 1/4 CORNER.  
CORNER RESET FOR COLD-IN-PLACE RECYCLE & H.M.A. RESURF. PROJECT LFM-503--7X-07.  
PRIOR TO RESURF. PROJECT, FOUND #5 (5/8") REBAR PER CURRENT RECORD AND TEMP. REF.  
CORNER LOCATION PER RTK GPS. AFTER 4" DEEP MILL & RECYCLE COURSE, NO SOUNDING  
REMAINED & NO EXCAVATION DONE @ LOCATION. AFTER +3" H.M.A. RESURF. COURSE, RESET  
CORNER WITH 5/8" (#5) x ±8" L REBAR w/ YELLOW PLASTIC CAP (Y.P.C.) #15748 LOCATED  
@ ±3' (0.25') SOUTH OF C.L. H.M.A. JOINT AND ALIGNED ± WITH EXISTING STEEL FENCE  
POST TO NORTH.

PLAN VIEW  
"NOT TO SCALE"

BHco Hist. Ties: BK. #1003 p. 32 T90-R11  
FIELD BOOK: Ties per Topcon 7003i #Z0115

(Show a minimum of three reference ties to durable physical objects, relevant monuments and physical conditions that will enable recovery of the corner.)


- 1.) TIES PER EDM MEASURE IN EITHER PRISM "OR" NON-PRISM MODE, WHILE UTILIZING "INDIRECT" MEASURE, WITH ALL DISTANCES PLUMB/HORIZ. (HD), UNLESS DENOTED.
- 2.) SECTION LINE MEASURE REFERS TO "LOCAL GROUND" DIST. AND INCLUDES ELLIPSOID (COMBINED) SCALE FACTOR FROM S.P.C. GRID INVERSE (AS OBSERVED), PER AVG. SCALE FACTOR = 1.000094315883.

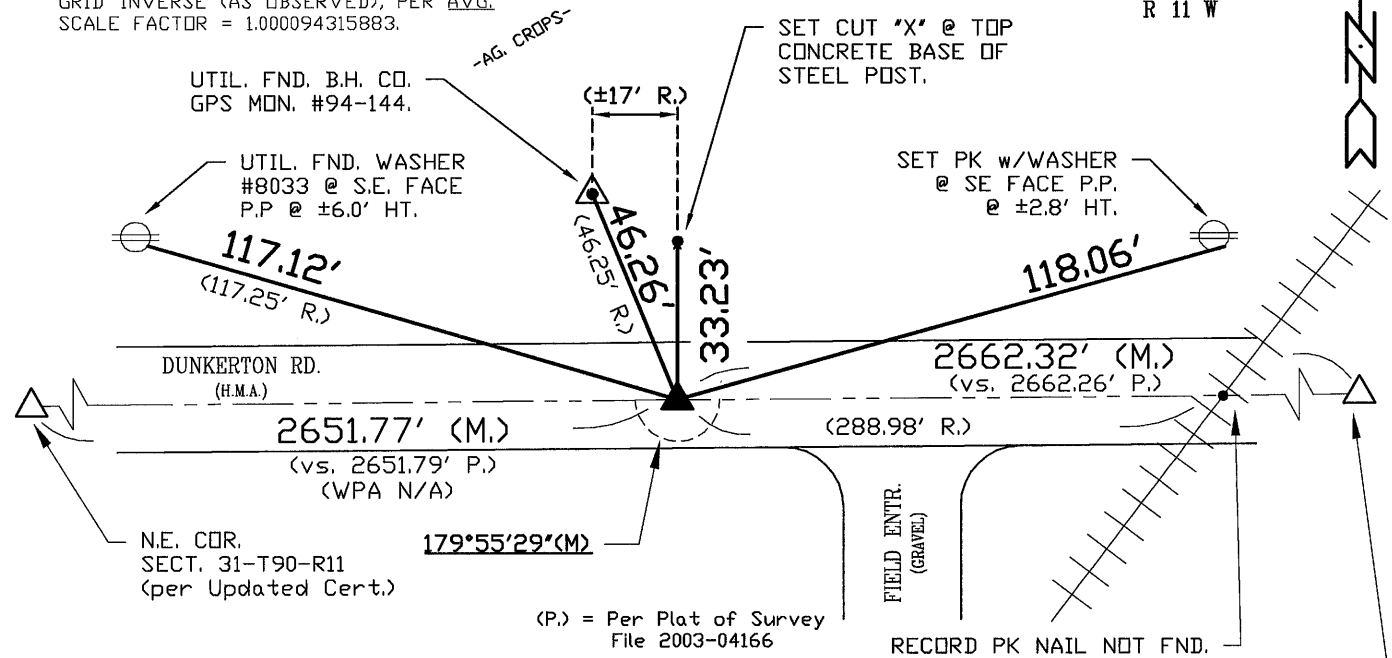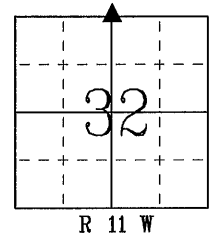

S.P.C., Ia. N. Zone, USft  
N = 3673575.75  
E = 5279319.00  
CONVERGENCE = 0° 54' 03"  
(NAD83-NSRS2007 "BHco07", RTK OBS.)

RECORD PK NAIL NOT FND.  
NOR RESET PER UPDATED R.R.  
GRADE CROSSING PANELS.  
N.E. COR. SECT. 32-T90-R11 (per Misc. 331, p. 245.)  
FIELD SURVEY: S.S. & V.S. 7/10/12  
PREPARED BY: S.S. & G.T. 12/4/12

CERTIFICATION

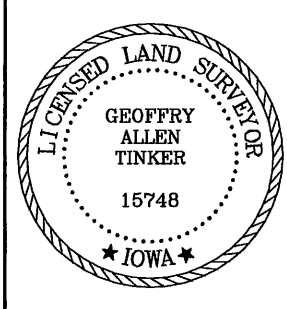

I hereby certify that this land surveying document was prepared and the related survey work was performed by me or under my direct personal supervision and that I am a duly licensed Land Surveyor under the laws of the State of Iowa.  
*Geoffrey Allen Tinker* 12/04/2012 (date)  
Geoffrey Allen Tinker  
License Number 15748  
My license renewal date is December 31, 2012  
Pages or sheets covered by this seal:  
This Land Corner Certificate Only.

LIST CORNERS TO BE INDEXED

Corner	Section	Township	Range
N. 1/4 Cor.	32	90 N	11 W
S. 1/4 Cor.	29	90 N	11 W

INDEX OF ABBREVIATIONS

- (M) = "Measured" Dimension  
(P) = "Platted" Dimension  
(R) = "Record" Dimension  
(C) = "Calculated" Dimension  
"IGS" = Iowa Geodetic Survey  
"WPA" = Works Progress Admin. Survey  
"G" = per George Miller Survey (BHco Surveyor 1858-1860)  
"B" = per John Ball Survey (BHco Surveyor 1866-1891)  
"N" = per Nathan Barber Survey (BHco Surveyor 1908-1931)  
"NP" = Reflectorless EDM Meas.  
"MLM" = Indirect Measure  
"CM" = Concrete Monument  
"SM" = Survey Marker Spike/Tag  
"PK" = PK/MAG Nail Brand Style