

Patricia A. Jess

WAYNE CLAASSEN ENGINEERING AND SURVEYING INC

WAYNE CLAASSEN ENGINEERING AND SURVEYING, INC.
P.O. BOX 898 WATERLOO, IOWA 50704-0898PHONE: (VOICE) 319-235-6294
(FAX) 319-235-0028

UNITED STATES PUBLIC LAND SURVEY CORNER CERTIFICATE


Land Survey Monuments situated in Section 32, Township 90N, Range 11W, of the Fifth Principal Meridian, Black Hawk County, Iowa.
Previously recorded in N/A in County Recorder's Office.
(book, page, document number, etc.)

(Show reason for preparing this certificate, the evidence and detailed procedures used in establishing the corner positions and monumentation found or placed.)

Monument Description and Remarks W 1/4 CORNER, FOUND 1/2" REBAR & CAP No. 8033 set by CES 5-10-1989 OVER SOM 10" DEEP.

PLAN - VIEW

(Show a minimum of three reference ties to durable physical objects, relevant monuments and physical conditions that will enable recovery of the corner.)

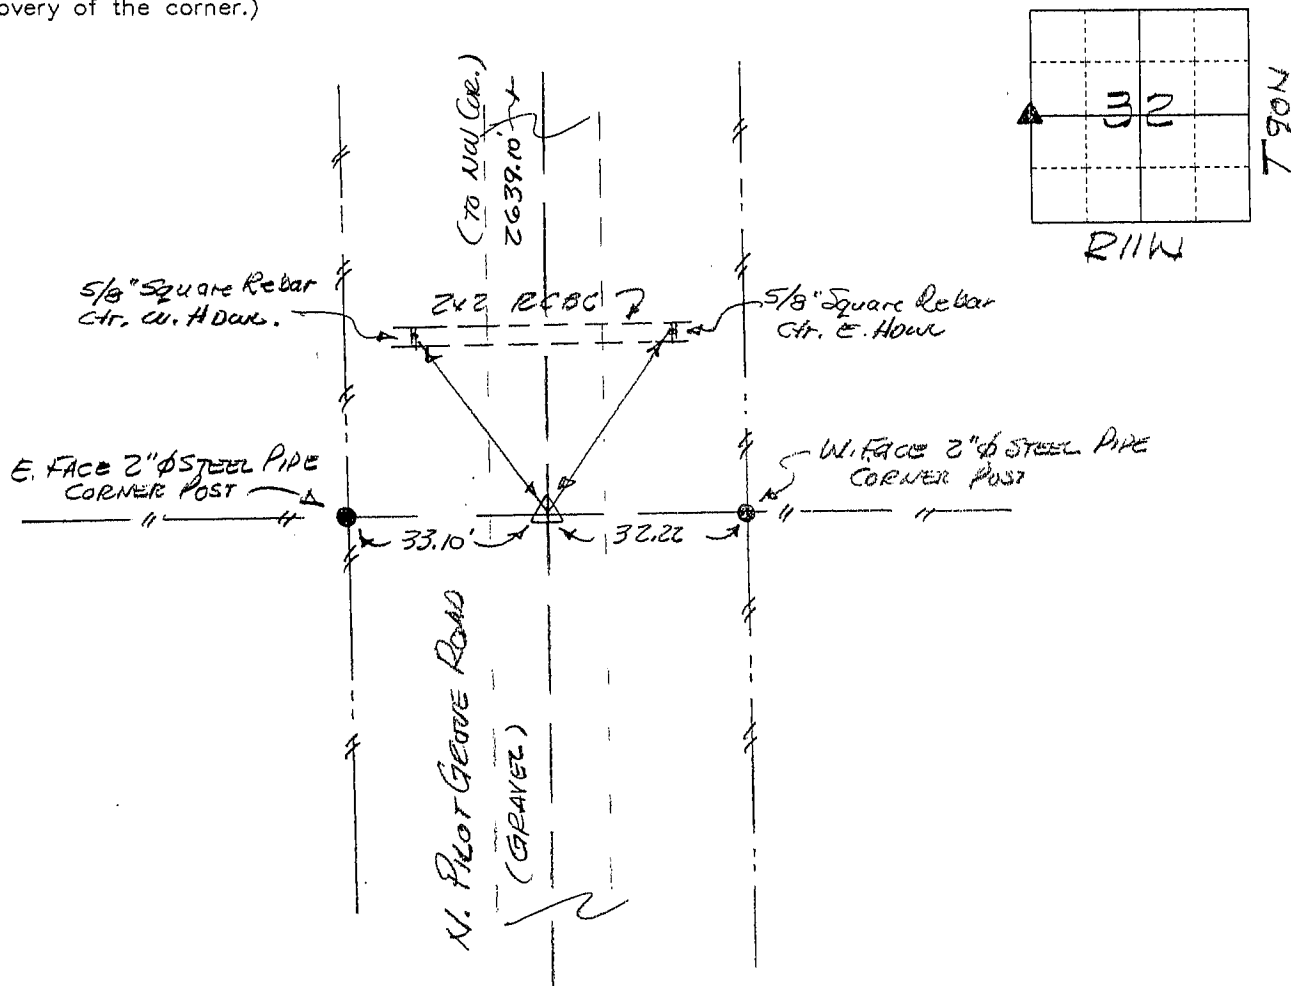


572-13

I hereby certify that the survey work was completed and this certificate was prepared by me or under my direct personal supervision and that I am a duly licensed land surveyor under the laws of the state of Iowa.

Signature: F. William King(Name typed or printed:) F. WILLIAM KINGDate: June 18, 2002Lic. No. 8033

SEAL

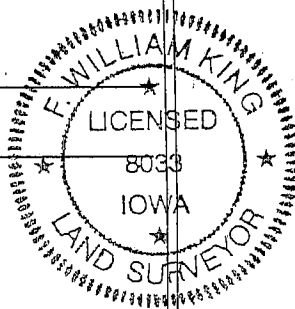

List Corners to be Indexed

Corners	Section	Twp	Range
<u>W 1/4</u>	<u>32</u>	<u>90N</u>	<u>11W</u>