FILED FOR RECORD COMPARED

2003 AT 4:00P M. FEE

BLACK HAWK COUNTY ENGINEER

BLACK HAWK COUNTY RECORDER

BLACK HAWK COUNTY ENGINEERS OFFICE PREPARED BY:

WATERLOO, IOWA 50703 316 E. FIFTH STREET, ROOM 211

PH.# (319) 833-3008 FAX.# (319) 833-3139

UNITED STATES PUBLIC LAND SURVEY CORNER CERTIFICATE OF


Land Survey Monuments situated in Section\_\_\_ 36 \_\_ , Township<u>90 N</u> Range 11 W, of the Fifth Principal Meridian, BLACK HAWK County, Iowa. Previously recorded in Misc. Book N/A, Page N/A, in County Recorder's Office.

(Show reason for preparing this certificate, the evidence and detailed procedures used in establishing the corner positions and monumentation found or placed.)

Monument Description and Remarks: <u>FOUND VERT. LIMESTONE 9"x2"x24" w/5"x2" TOP @ 7" DP. "and" 6"x8"x8" POINTED (N. SIDE) LIMESTONE (POSSIBLE</u> "4" SCRIBED ON N. FACE) @ 12" DP. LOC. N.E. OF ACCEPTED VERT. STONE 5'x4'x2-1/2' DP. EXCAVATION HOLE. EST. 2-#5 RBR. BETWEEN FND. STONES FOR MAGNETIC LOC. @ 7" BELOW TOP VERT. STONE & CUT \* TOP CENTER VERT. STONE w/ ACCEPTED STONE ALIGNED TO N-S CARDINAL DIRECTIONS.

## PLAN - VIEW

(Show a minimum of three reference ties to durable physical objects, relevant monuments and physical conditions that will enable recovery of the corner.)

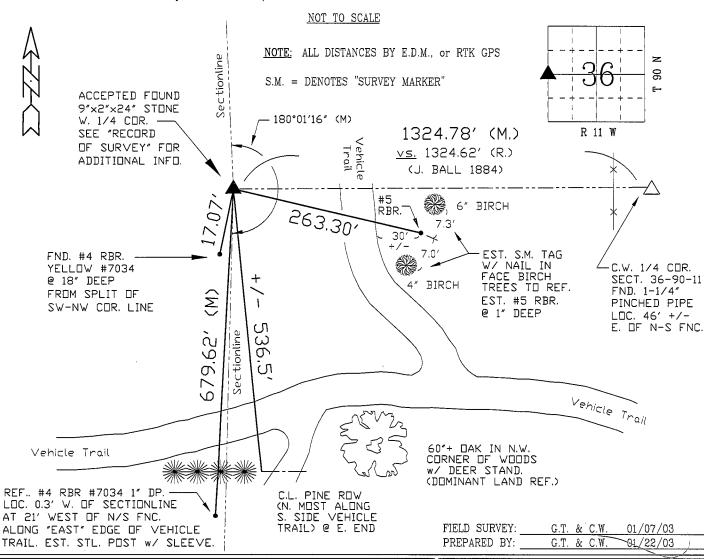

## <u>CERTIFICATION</u>

I hereby certify that this land surveying document was prepared and the related survey work was performed by me or under my direct personal supervision and that I am a duly licensed Land Surveyor under the laws of the State of Iowa.

Westfry C Geoffry Allen Hinker 02/10/03 /unle-

License Number

GEOFFRY

TINKER

\*AWOI \*

My license renewal date is December 31,

Pages or sheets covered by this seal:

This Land Corner Certificate Only.

## LIST CORNERS TO BE INDEXED

<u>Corner</u>	<u>Section</u> -	- <u>Township</u>	- <u>Range</u>
W. 1/4	36	90 N	11 W
E. 1/4	35	90 N	11 W