

IRS
P
Z

Document Number: 2007001449
Date: Jul 19, 2006 1:56:44 pm
Aud Fee: 0.00 Rec Fee: 0.00
Trans Tax: 0.00 Rec Management Fee: 0.00
E-Com Fee: 0.00 Non-Standard Page Fee: 0.00
Filed for record in Black Hawk County, Iowa
Patricia S. Sass, County Recorder

PREPARED BY: BLACK HAWK COUNTY ENGINEERS OFFICE
316 E. FIFTH STREET, ROOM 211 WATERLOO, IOWA 50703
PH.# (319) 833-3008 SLSI 9-94
FAX.# (319) 833-3139 CERT 12-96

UNITED STATES PUBLIC LAND SURVEY CORNER CERTIFICATE OF
Land Survey Monuments situated in Section 02, Township 90 N,
Range 12 W, of the Fifth Principal Meridian, BLACK HAWK County, Iowa.
Previously recorded in Misc. Book 342, Page 988, in County Recorder's Office.
(Show reason for preparing this certificate, the evidence and detailed procedures used in establishing the corner
positions and monumentation found or placed.)

Monument Description and Remarks: FND #5 RBR @ CENTERLINE INTERSECTION
PRIOR TO RESURF. PROJECT. SURFACE MILLED DOWN @ LOCATION PRIOR TO 4 1/2" HMA
RE-SURFACING. SECTION LINE MEAS. PER RTK GPS, 1999/2000 MAPPING PROJECT.
RE-SET WITH 5in L. #5 REBAR LOCATED 0.15' WEST OF C.L. ACC JOINT, BEING ±
CENTER OF INTERSECTION DENOTED. ORIG. FND. REBAR MAG. SOUNDED TO AREA
SOUTHEAST, SEVERLY BENT AND MOST EVIDENTLY LAYING ON SIDE FROM MILLING
MACHINE, PER PROJECT INSPECTOR NOTES (C.W.).



PLAN - VIEW

(Show a minimum of three reference ties to durable physical objects, relevant monuments and physical conditions
that will enable recovery of the corner.)

NOT TO SCALE

NOTES:

- 1.) TIE DIST. PER EDM MEASURE
- 2.) SECTION LINE DISTANCE REFERS TO "LOCAL GROUND" MEAS. AND INCLUDES ELLIPSOIDAL (COMBINED) SCALE FACTOR FROM S.P.C. INVERSE (AS OBSERVED).

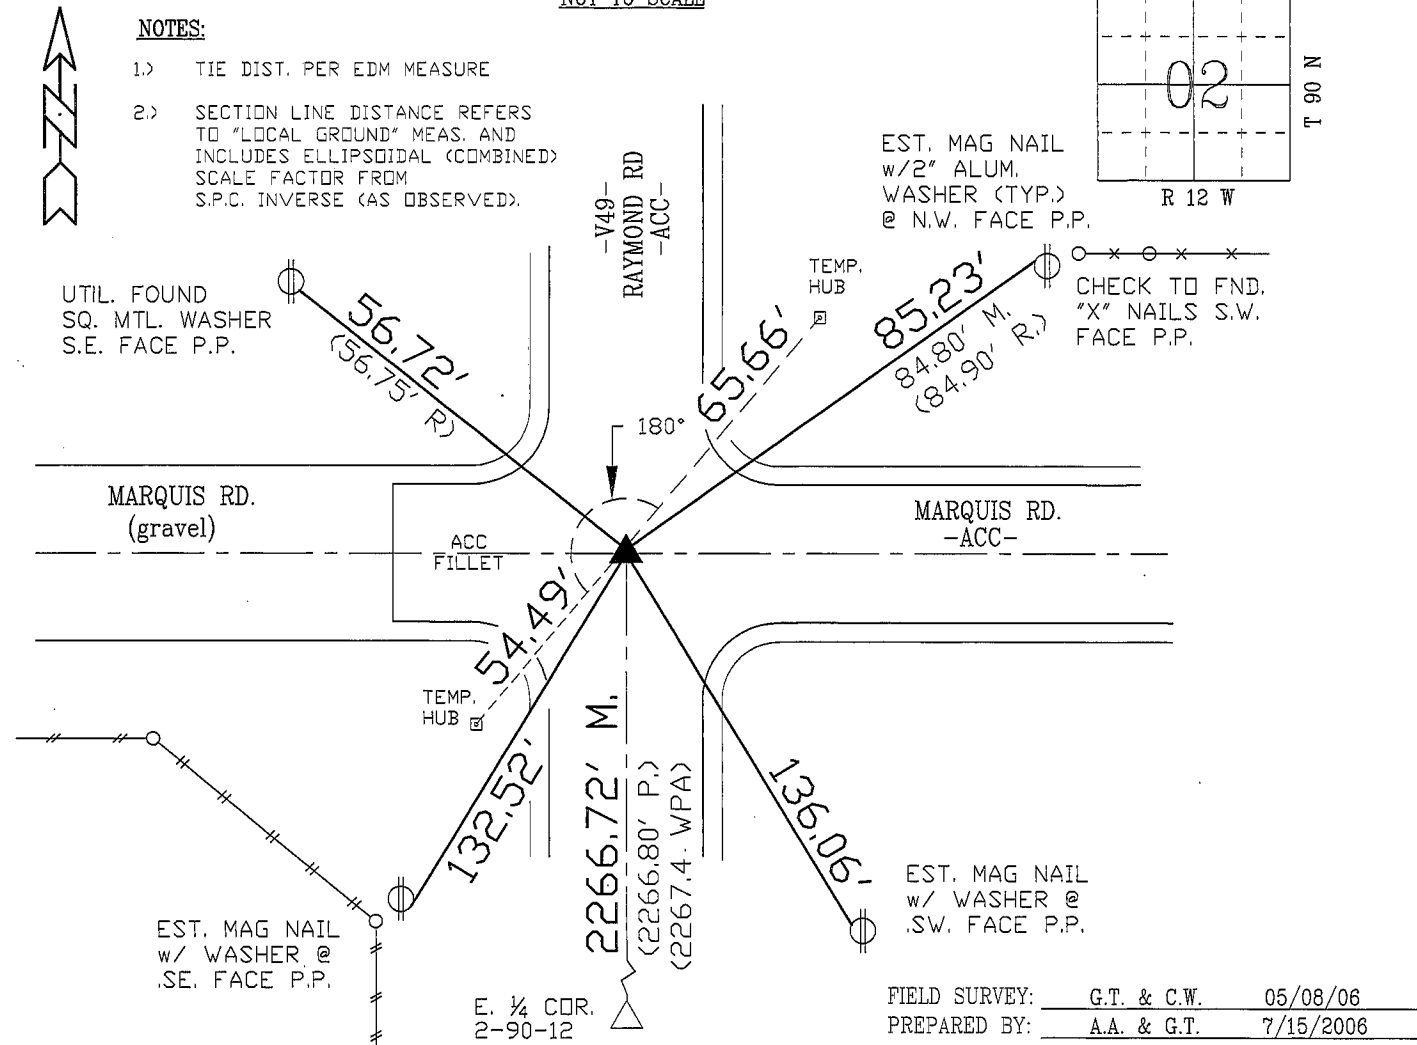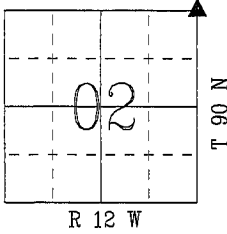

CERTIFICATION

RICHARD L. KING
3890
IOWA

I hereby certify that this land surveying document was prepared and the related survey work was performed by me or under my direct personal supervision and that I am a duly licensed Land Surveyor under the laws of the State of Iowa.

Richard L. King 7/19/06
Richard L. King (date)

License Number 3890

My license renewal date is December 31, 2007

Pages or sheets covered by this seal:
This Land Corner Certificate Only.

LIST CORNERS TO BE INDEXED

Corner	Section	Township	Range
N.E. COR.	2	90 N	12 W
N.W. COR.	1	90 N	12 W