



# United States Public Land Survey Corner Certificate

 $\{$ 

- Monument Description and Remarks:**

## Plan View

(Show a minimum of three reference ties to durable physical objects, relevant monuments and physical conditions that will enable recovery of the corner.)

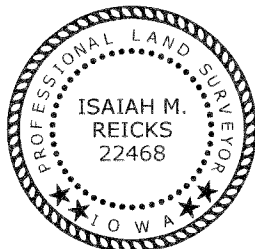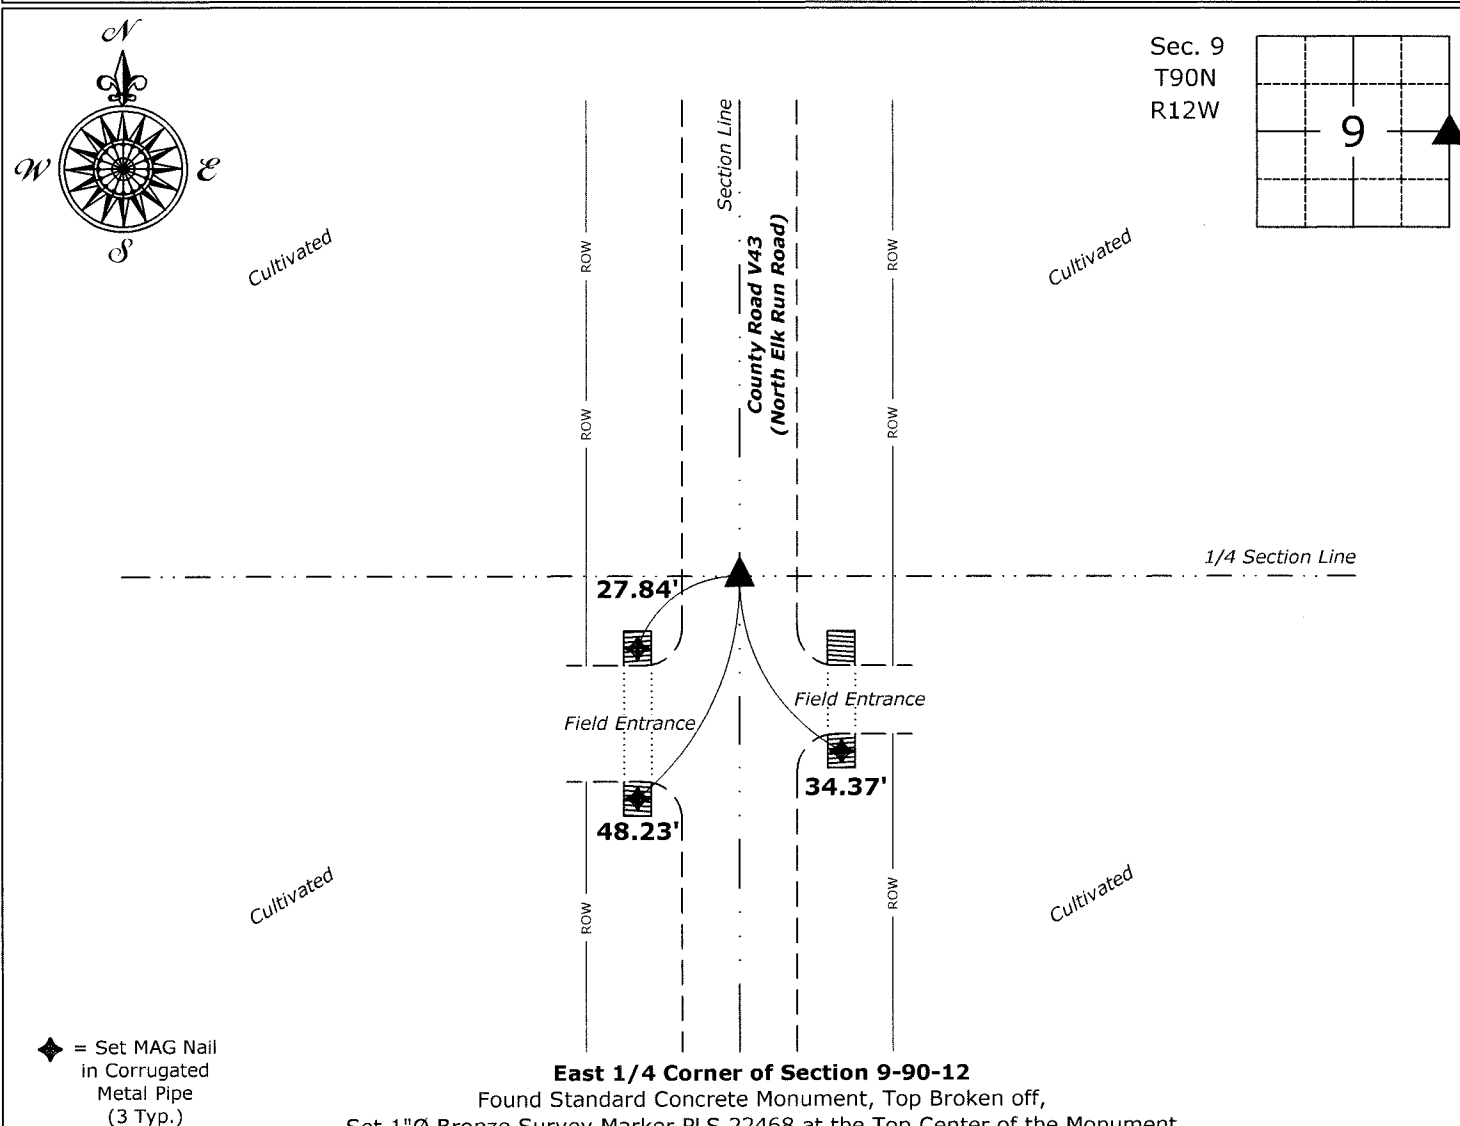

License number 22468  
My license renewal date is December 31, 2021.  
Sheets covered by this seal: Individual sheet only

List Corner to be Indexed			
Corner	Section	Twp.	Range
E 1/4	9	90	12

Project Number: 2020-588

File Number: 2021-000135-598 Seq: 1