

Number: 202100015399  
Recorded: 1/21/2021 at 2:21:49.0 PM  
County Recording Fee: \$7.00  
Iowa E-Filing Fee: \$3.00  
Combined Fee: \$10.00  
Revenue Tax:  
Sandie L. Smith, RECORDER  
Black Hawk County, Iowa

Prepared by & Return to: Herold - Reicks Surveying, 2206 East Bremer Avenue, Waverly, IA 50677, Ph. 319-483-5187

United States Public Land Survey Corner Certificate

Land Survey Monument situated in  
Section 9, Township 90 North, Range 12 West of the Fifth Principal Meridian, **Black Hawk** County, Iowa.  
Not On file in the County Recorder's office.

This certificate is being prepared in compliance with Iowa Code Chapter 355.11 because:




- ☒ There is no certificate on file for this corner.
- ☐ There are no longer three valid ties of record.
- ☐ There are changes to reference ties of record.
- ☐ There is change of monumentation of record.
- ☐ To clarify description of record monument (ties).

Monument Description and Remarks:

**North 1/4 Corner:** Found 1/2"Ø Rebar w/2"Ø Aluminum Cap PLS 10793 with information obtained from a Survey and Plat, as recorded in Book 327, Page 589 on file in the County Recorder's Office.

Plan View

(Show a minimum of three reference ties to durable physical objects, relevant monuments and physical conditions that will enable recovery of the corner.)

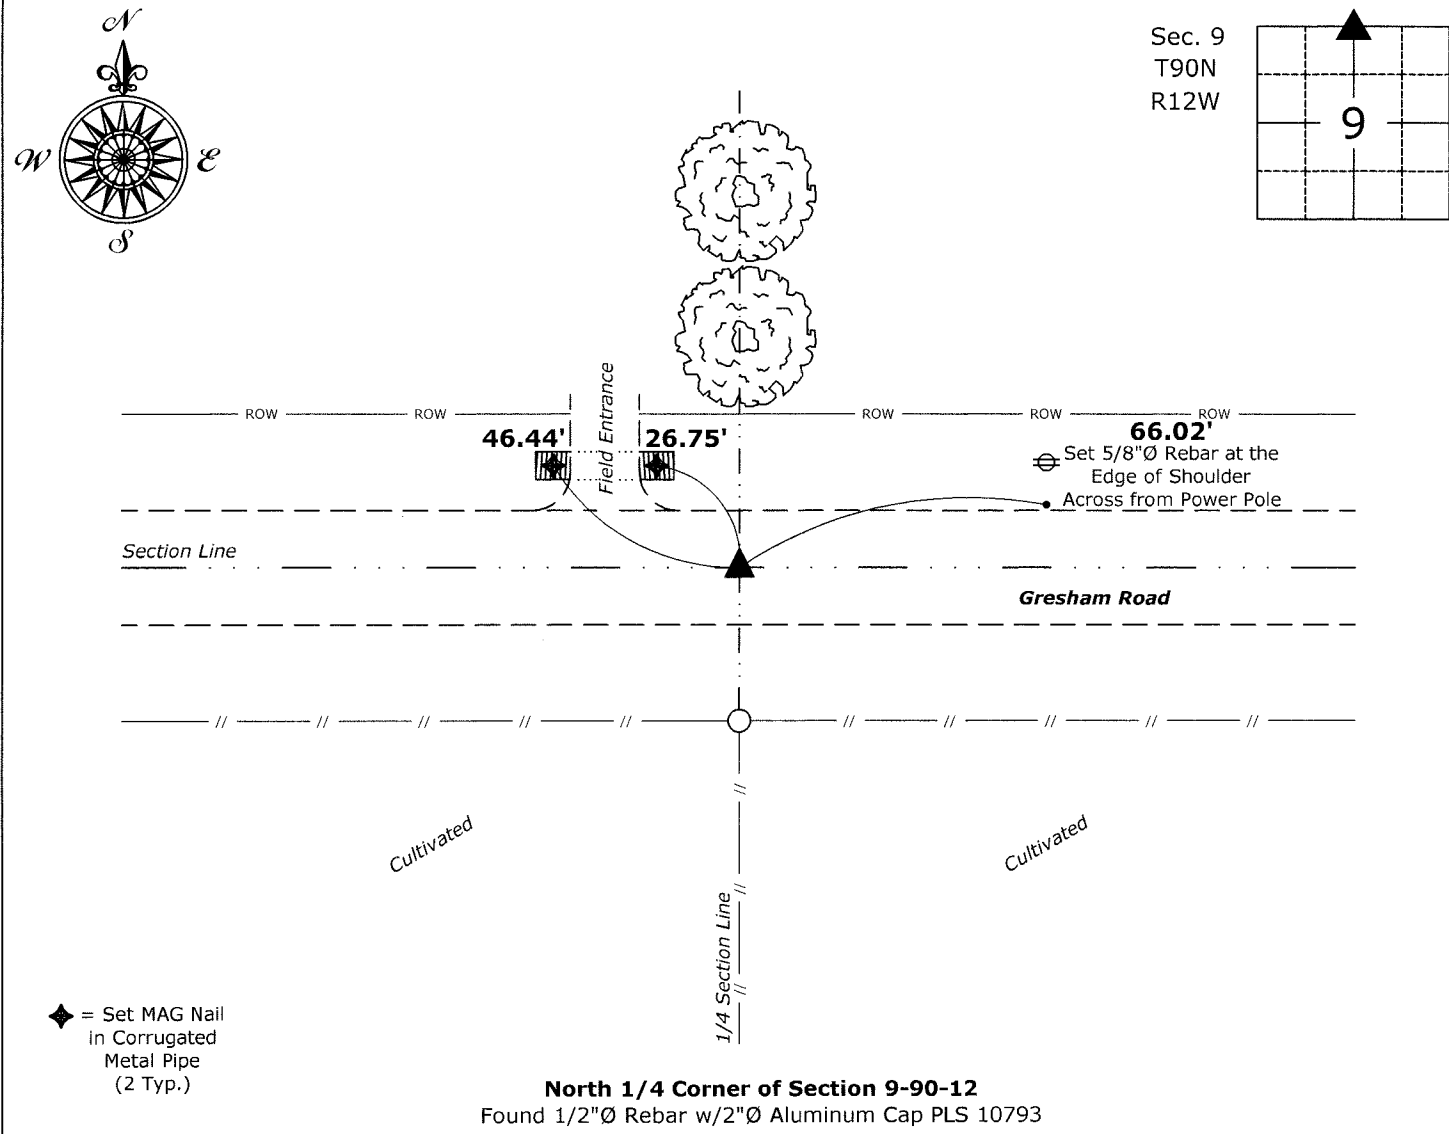

**North 1/4 Corner of Section 9-90-12**  
Found 1/2"Ø Rebar w/2"Ø Aluminum Cap PLS 10793



I hereby certify that this land surveying document was prepared and the related survey work was performed by me or under my direct personal supervision and that I am a duly licensed Land Surveyor under the laws of the State of Iowa.  
*Isaiah M. Reicks*  
Isaiah M. Reicks Date: 1-21-21  
License number 22468  
My license renewal date is December 31, 2021.  
Sheets covered by this seal: Individual sheet only

List Corner to be Indexed			
Corner	Section	Twp.	Range
N 1/4	9	90	12
Project Number: 2020-588			
File Number: 2021-00015399 Seq: 1			