

I RS  
P  
Z

Document Number: 2007001452  
Date: Jul 19, 2006 1:59:26 pm  
Aud Fee: 0.00 Rec Fee: 0.00  
Trans Tax: 0.00 Rec Management Fee: 0.00  
E-Com Fee: 0.00 Non-Standard Page Fee: 0.00  
Filed for record in Black Hawk County, Iowa  
Patricia S. Sass, County Recorder

PREPARED BY: BLACK HAWK COUNTY ENGINEERS OFFICE  
316 E. FIFTH STREET, ROOM 211 WATERLOO, IOWA 50703  
PH.# (319) 833-3008 SLS# 9-94  
FAX.# (319) 833-3139 CERT 12-96

UNITED STATES PUBLIC LAND SURVEY CORNER CERTIFICATE OF  
Land Survey Monuments situated in Section 11, Township 90 N,  
Range 12 W, of the Fifth Principal Meridian, BLACK HAWK County, Iowa.  
Previously recorded in Misc. Book n/a, Page n/a, in County Recorder's Office.

(Show reason for preparing this certificate, the evidence and detailed procedures used in establishing the corner positions and monumentation found or placed.)


Monument Description and Remarks: FND. #5 RBR. IN C.L. ACC PRIOR TO  
RESURF. PROJECT. PLAN 4 1/2"-5" HMA RESURF. PROPOSED. GEOM. DEFL. AND  
SECTIONLINE REFERENCES PER RTK GPS MEAS., 1999/2000 MAPPING PROJECTS.  
RE-SET WITH 5IN. L. #5 REBAR LOCATED 0.20' EAST OF C.L. ACC JOINT, AND  
ALIGNED (±) WITH STEEL CORNER POST ON EAST RIGHT-OF-WAY.

PLAN - VIEW


(Show a minimum of three reference ties to durable physical objects, relevant monuments and physical conditions that will enable recovery of the corner.)

NOTES:

- 1> TIE DIST. PLUMB (H.D.)  
2> SECTIONLINE REFERENCES  
REFER TO "LOCAL GROUND"  
MEAS. AND INCLUDE ELLIPSOID  
(COMBINED) SCALE FACTOR

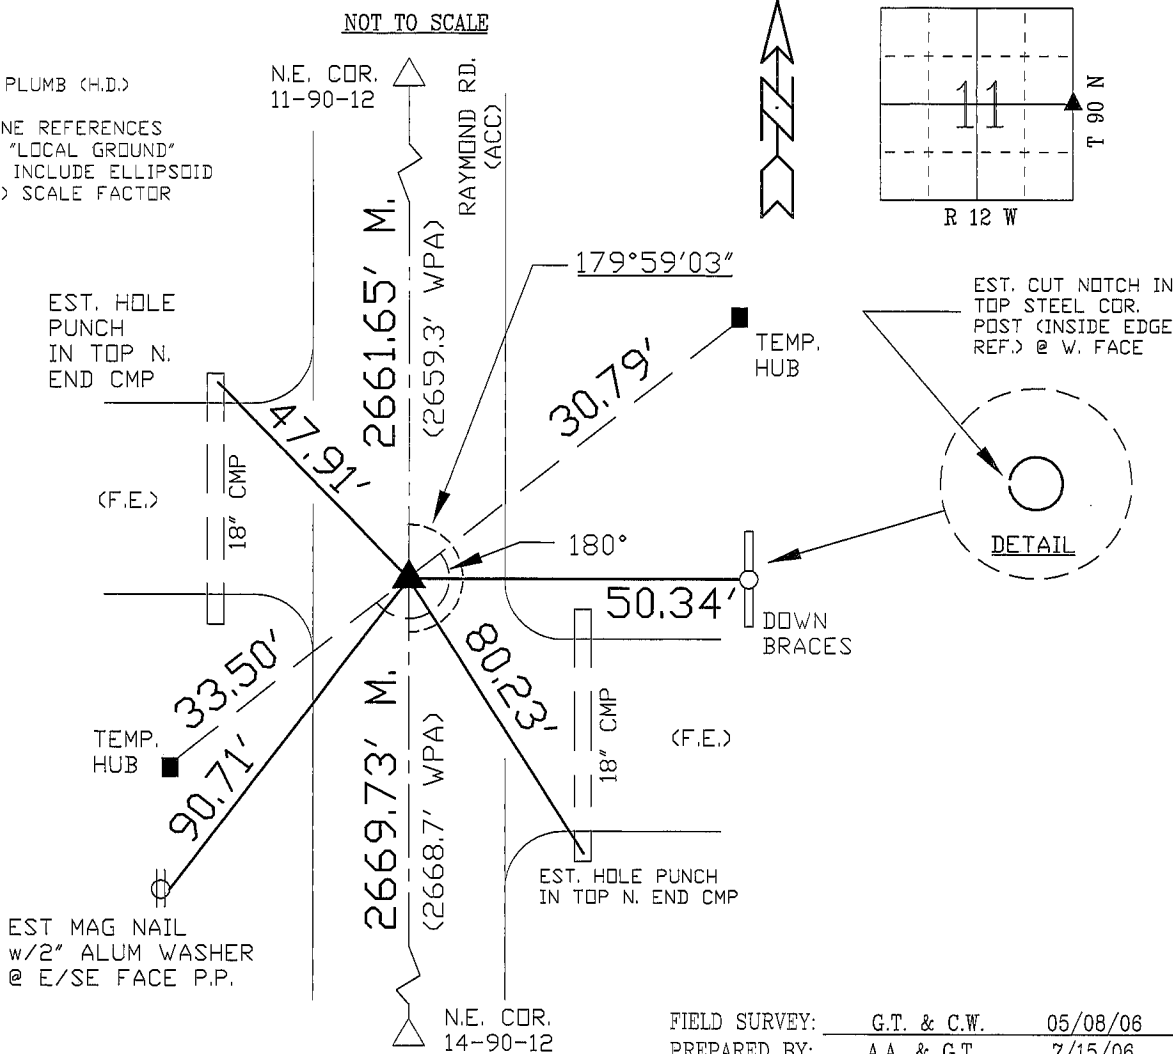

CERTIFICATION

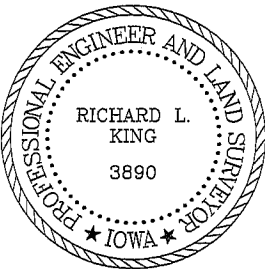

I hereby certify that this land surveying document was prepared and the related survey work was performed by me or under my direct personal supervision and that I am a duly licensed Land Surveyor under the laws of the State of Iowa.  
*Richard L. King* 7/17/06  
Richard L. King (date)  
License Number 3890  
My license renewal date is December 31, 2007  
Pages or sheets covered by this seal:  
This Land Corner Certificate Only.

LIST CORNERS TO BE INDEXED

Corner	Section	Township	Range
E. 1/4	11	90 N	12 W
W. 1/4	12	90 N	12 W