Document Number: 2007001451

0.00

Jul 19, 2006 Date: Aud Fee:

Trans Tax:

0.00

Rec Fee: 0.00 Rec Management Fee:

0.00 0.00

E-Com Fee: 0.00 Non-Standard Page Fee: Filed for record in Black Hawk County, Iowa

 \mathbf{Z}

Patricia S. Sass, County Recorder

PREPARED BY:

BLACK HAWK COUNTY ENGINEERS OFFICE

316 E. FIFTH STREET, ROOM 211

WATERLOO, IOWA 50703

PH.# (319) 833-3008 FAX.# (319) 833-3139

SLSI 9-94 CERT 12-96

UNITED STATES PUBLIC LAND SURVEY CORNER CERTIFICATE OF


Land Survey Monuments situated in Section 11 , Township 90 N Range 12 W, of the Fifth Principal Meridian, BLACK HAWK County, Iowa. Previously recorded in FEE. Book 2004, Page 31216, in County Recorder's Office.

(Show reason for preparing this certificate, the evidence and detailed procedures used in establishing the corner positions and monumentation found or placed.)


Monument Description and Remarks: FND #5 REBAR PRIOR TO RESURF PROJECT, AND REFERENCED AS SHOWN. PLAN 4½"-5" HMA RESURF, PROPOSED. GEOM, DEFL. AND SECTIONLINE MEAS, PER RTK GPS, 1999/2000 MAPPING PROJECT. WITH 5IN. L. #5 REBAR LOCATED ± C.L. ACC JOINT BEING ALIGNED WITH SIDEROAD, AS SHOWN.

PLAN - VIEW

(Show a minimum of three reference ties to durable physical objects, relevant monuments and physical conditions that will enable recovery of the corner.)

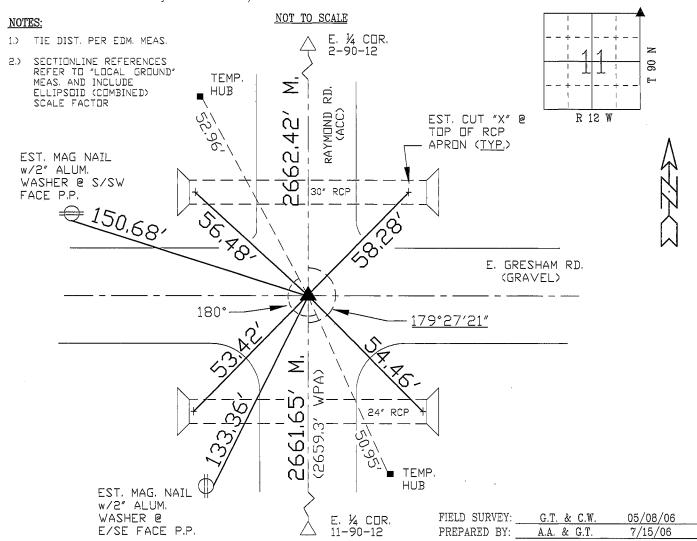

${\it CERTIFICATION}$

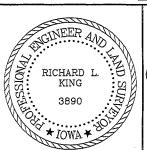

I hereby certify that this land surveying document was prepared and the related survey work was performed by me or under my direct personal supervision and that I am a duly licensed Land Surveyor under the laws of the State of Iowa.

My license renewal date is December 31,_

Pages or sheets covered by this seal:

This Land Corner Certificate Only

LIST CORNERS TO BE INDEXED

Corner	Section -	- <u>Township</u>	- <u>Range</u>
N.E. COR.	11	90 N	12 W
N.W. COR.	12	90 N	12 W
S.W. COR	1	90 N	12 W
S.E. COR	2	90 N	12 W