



Doc ID: 005574820001 Type: GEN
Recorded: 09/15/2014 at 10:45:42 AM
Fee Amt: \$7.00 Page 1 of 1
Black Hawk County Iowa
JUDITH A MCCARTHY RECORDER

File 2015-00004768

Prepared by & Return to: Herold - Reicks Surveying, 10 East Main Street, New Hampton, IA 50659, Ph. 641-394-2725

UNITED STATES PUBLIC LAND SURVEY CORNER CERTIFICATE

Land Survey Monuments situated in Section **18**, Township **90** North, Range **12** West of the Fifth Principal Meridian, **Black Hawk** County, Iowa. Previously not recorded in the County Recorder's office.

This certificate is being prepared in compliance with Iowa Code Chapter 355.11 because:

- 1 & 2 ☒ There is no certificate on file for this corner.
☐ There are no longer three valid ties of record.
☐ There are changes to reference ties of record.
☐ There is change of monumentation of record.
☐ To clarify description of record monument (ties).


Monument Description and Remarks:

1.) West 1/4 Corner: Found 1/2"Ø rebar from information obtained from a Iowa Department of Transportation Corner Stone Survey made by Robert Burns RLS #6705, signed February 23, 1981, Project No. F-63-6(903)--20-07.

2.) Southwest Corner: Found 4" x 4" Concrete Monument w/Brass Cap, the previous Section Corner Certificate, Doc. #2013-00015753 indicated a 1/2"Ø iron rod, it was not located, excavated the area and found a standard Section Corner Monument. One tie that matched previous record. This certificate is being prepared to provide additional ties.

PLAN - VIEW

(Show a minimum of three reference ties to durable physical objects, relevant monuments and physical conditions that will enable recovery of the corner.)

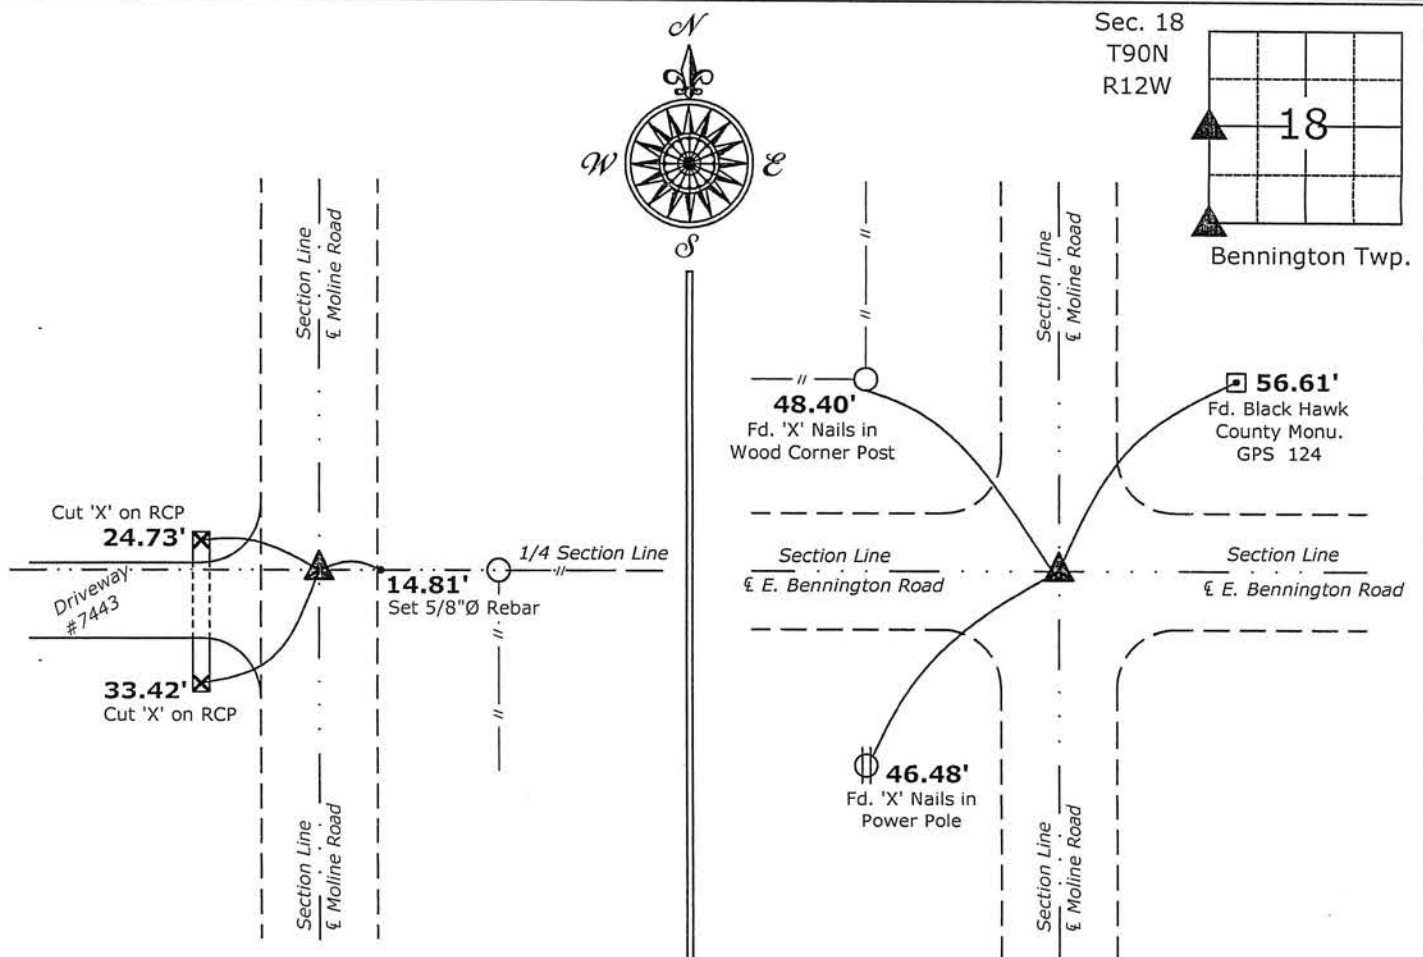

1.) West 1/4 Corner Section 18-90-12
Found 1/2"Ø Rebar

2.) Southwest Corner Section 18-90-12
Found 4" x 4" Concrete Monument w/Brass Cap



I hereby certify that this land surveying document was prepared and the related survey work was performed by me or under my direct personal supervision and that I am a duly licensed Land Surveyor under the laws of the State of Iowa.

Paul R. Herold 9-12-14
Paul R. Herold Date:

License number 15525
My license renewal date is December 31, 2014.
Sheets covered by this seal: Individual sheet only

List Corners to be Indexed

Corners	Section	Twp.	Range
W1/4	18	90	12
SW	18	90	12

Project Number: 2014-182

FB: Black Hawk County 1, Pgs. 21-22