Projects - WO\County Control Systems_WO\BLACK HAWK\BHCO-9\BHCO-9\dwg, 12/4/2020 11:10:11 AM

Number: 202100012056

Recorded: 12/7/2020 at 9:11:18.0 AM

County Recording Fee: \$7.00 Iowa E-Filing Fee: \$3.00 Combined Fee: \$10.00

Revenue Tax:

Sandie L. Smith, RECORDER **Black Hawk County, Iowa**

Prepared by & Return to: Herold - Reicks Surveying, 2206 East Bremer Avenue, Waverly, IA 50677, Ph. 319-483-5187

Corrective United States Public Land Survey Corner Certificate Land Survey Monument situated in

Section 23, Township 90 North, Range 12 West of the Fifth Principal Meridian, Black Hawk County, Iowa. Not on file in the County Recorder's office.

This certificate is being prepared in compliance with Iowa Code Chapter 355.11 because:



There is no certificate on file for this corner.

There are no longer three valid ties of record.

There are changes to reference ties of record.

There is change of monumentation of record.

To clarify description of record monument (ties).


Monument Description and Remarks:

Northwest Corner NE 1/4 - SW 1/4: Set 5/8"Ø Rebar w/2"Ø Aluminum Cap PLS 22468 equidistant and on line between the West Quarter Corner and Center of said Section.

An extensive search of all of the records within the County offices was performed as part of the section corner recovery. There were no records located of the perpetuation of a monument at this corner.

Plan View

(Show a minimum of three reference ties to durable physical objects, relevant monuments and physical conditions that will enable recovery of the corner.)

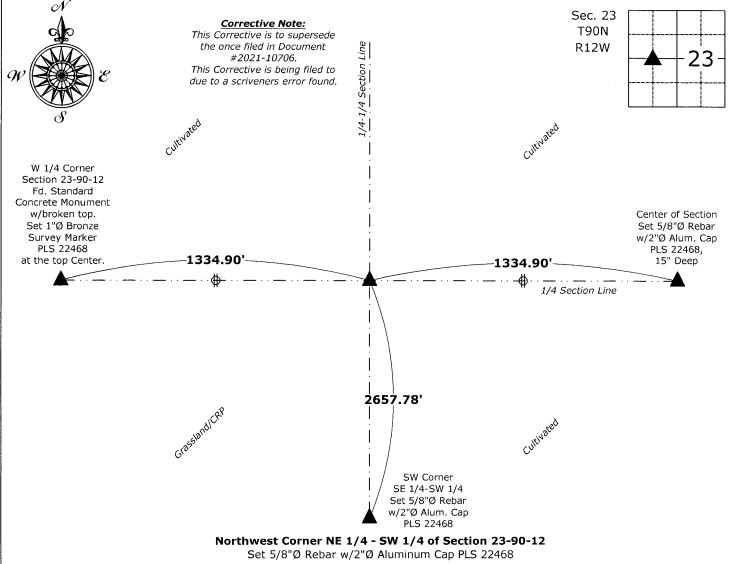



I hereby certify that this land surveying document was prepared and the related survey work was performed by me or under my direct personal supervision and that I am a duly licensed Land Surveyor under the laws of the State of Iowa.

Isaiah M. Reicks 12-4-20 Date:

License number 22468

My license renewal date is December 31, 2021. Sheets covered by this seal: Individual sheet only

Corner Section Twp. Range NW-NE-SW 90 12 23

List Corner to be Indexed

Project Number: 2020-562 File Nambert 2020-00012056