

IRS  
Pgm  
Z

Document Number: 2007001455  
Date: Jul 19, 2006 2:16:30 pm  
Aud Fee: 0.00 Rec Fee: 0.00  
Trans Tax: 0.00 Rec Management Fee: 0.00  
E-Com Fee: 0.00 Non-Standard Page Fee: 0.00  
Filed for record in Black Hawk County, Iowa  
Patricia S. Sass, County Recorder

PREPARED BY: BLACK HAWK COUNTY ENGINEERS OFFICE PH.# (319) 833-3008 SLSI 9-94  
316 E. FIFTH STREET, ROOM 211 WATERLOO, IOWA 50703 FAX.# (319) 833-3139 CERT 12-96

UNITED STATES PUBLIC LAND SURVEY CORNER CERTIFICATE OF  
Land Survey Monuments situated in Section 23, Township 90 N,  
Range 12 W, of the Fifth Principal Meridian, BLACK HAWK County, Iowa.  
Previously recorded in Misc. Book 329, Page 947, in County Recorder's Office.  
(Show reason for preparing this certificate, the evidence and detailed procedures used in establishing the corner  
positions and monumentation found or placed.)

Monument Description and Remarks: FND. #5 RBR. PRIOR TO RESURF. PROJECT.  
RECORD TIES PER PLS #3862 DESTROYED. CORNER ACCEPTED PER HIST. RECORD(S)  
AND PLAT OF SURVEY REFERENCE. PLAN 4 1/2"-5" HMA RESURF. PROPOSED.  
GEOM. DEFL. AND SECTION LINE REFERENCES PER RTK GPS MEAS., 1999/2000  
MAPPING PROJECT. RE-SET WITH 5IN. L. #5 REBAR LOCATED ±0.20' EAST OF C.L.  
ACC JOINT AND ALIGNED (±) WITH C.L. SIDEROAD, AS SHOWN.


PLAN - VIEW

(Show a minimum of three reference ties to durable physical objects, relevant monuments and physical conditions  
that will enable recovery of the corner.)

NOT TO SCALE


NOTES:

- 1.) TIE DIST. MEAS. PLUMB (H.D.)
- 2.) SECTIONLINE REFERENCES  
REFER TO "LOCAL GROUND"  
MEAS. AND INCLUDE ELLIPSOID  
(COMBINED) SCALE FACTOR

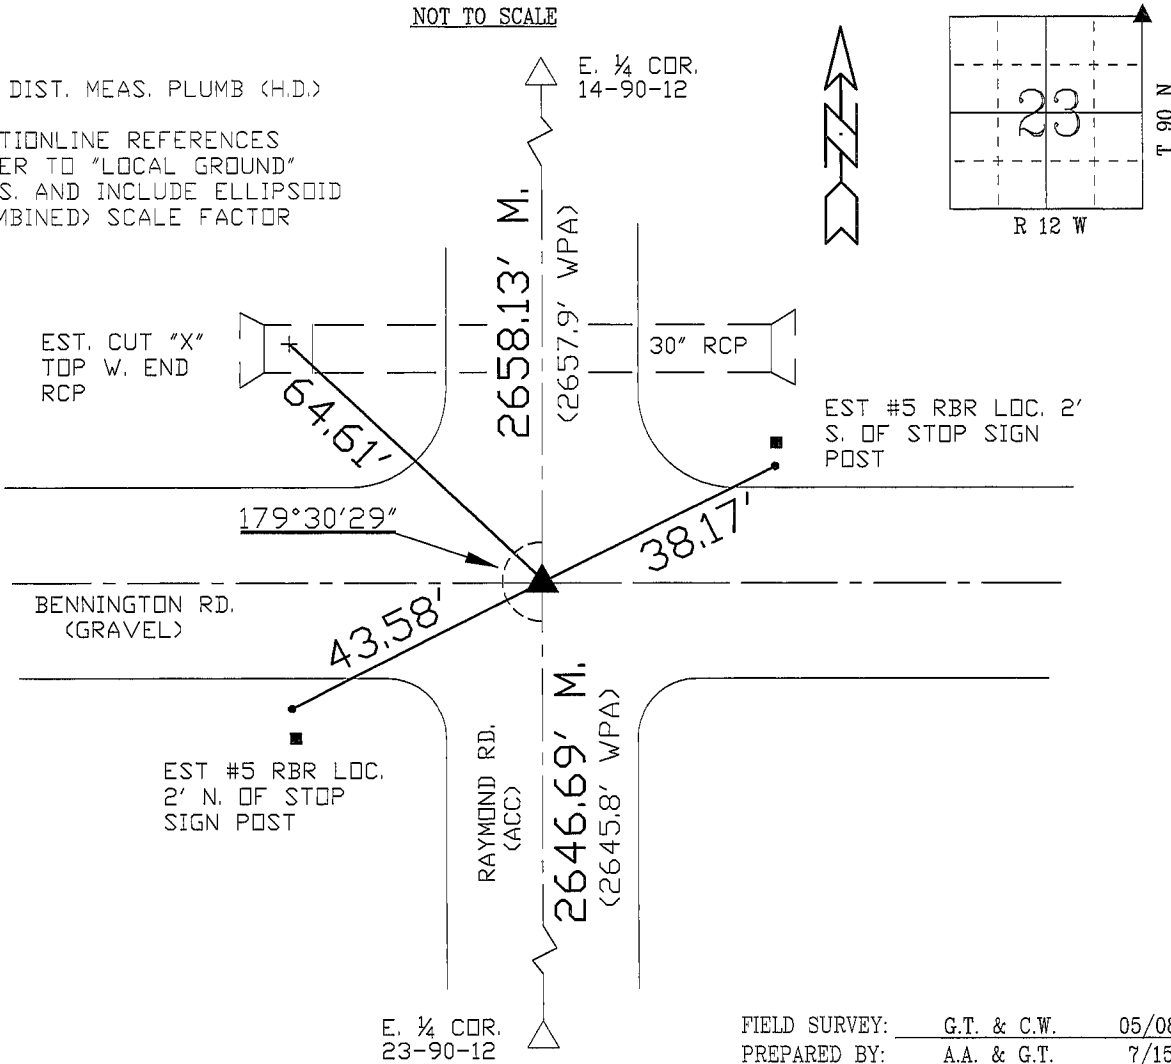

FIELD SURVEY: G.T. & C.W. 05/08/06  
PREPARED BY: A.A. & G.T. 7/15/06

CERTIFICATION

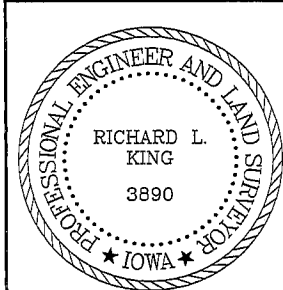

I hereby certify that this land surveying document  
was prepared and the related survey work was  
performed by me or under my direct personal  
supervision and that I am a duly licensed Land  
Surveyor under the laws of the State of Iowa.  
Richard L. King 7/17/06 (date)  
License Number 3890  
My license renewal date is December 31, 2007  
Pages or sheets covered by this seal:  
This Land Corner Certificate Only.

LIST CORNERS TO BE INDEXED

Corner	Section	Township	Range
N.E. COR	23	90 N	12 W
S.E. COR	14	90 N	12 W
N.W. COR	24	90 N	12 W
S.W. COR	13	90 N	12 W