



Doc ID: 003636700001 Type: GEN  
Recorded: 01/13/2009 at 04:16:07 PM  
Fee Amt: \$7.00 Page 1 of 1  
Instr# 200800014145  
Black Hawk County Iowa  
JUDITH A MCCARTHY RECORDER  
Book 1080 Page 6433 - 6433

File **2009-00012977**

*Herold - Reicks Surveying, 25 1/2 East Main Street, Suite 204, New Hampton, IA 50659, Ph. 641-394-2725*

## UNITED STATES PUBLIC LAND SURVEY CORNER CERTIFICATE

Land Survey Monuments situated in Section **25**, Township **90** North, Range **12** West of the Fifth Principal Meridian, **Black Hawk** County, Iowa. Not previously recorded in the County Recorder's office.

This certificate is being prepared in compliance with Iowa Code Chapter 355.11 because:





- ☒ There is no certificate on file for this corner.
- ☐ There are no longer three valid ties of record.
- ☐ There are changes to reference ties of record.
- ☐ There is change of monumentation of record.
- ☐ To clarify description of record monument (ties).

### Monument Description and Remarks:

- 1.) **Southwest Corner SE 1/4-NW 1/4:** Set 5/8"Ø rebar with 2"Ø aluminum cap PLS 15525 midway and online between West 1/4 Corner and Center of Section.
- 2.) **Northeast Corner SE 1/4-NW 1/4:** Set 5/8"Ø rebar with 2"Ø aluminum cap PLS 15525 midway and online between North 1/4 Corner and Center of Section.

### PLAN - VIEW

(Show a minimum of three reference ties to durable physical objects, relevant monuments and physical conditions that will enable recovery of the corner.)

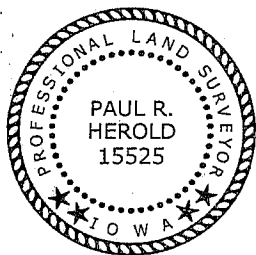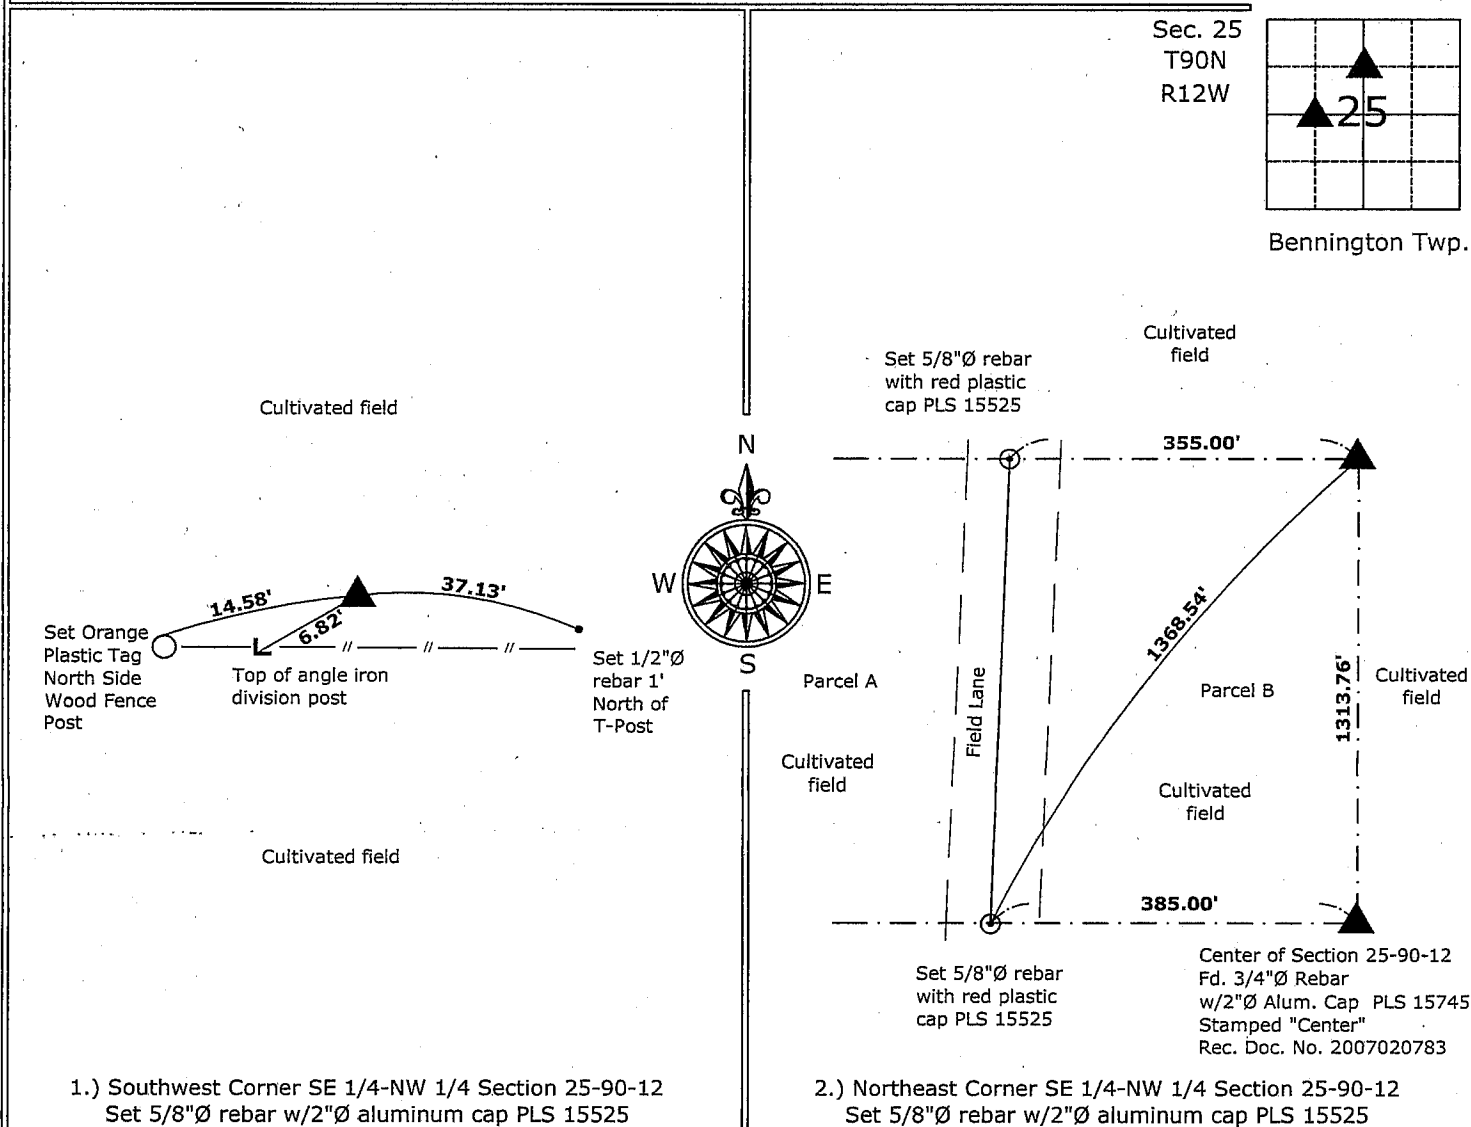

I hereby certify that this land surveying document was prepared and the related survey work was performed by me or under my direct personal supervision and that I am a duly licensed Land Surveyor under the laws of the State of Iowa.

*Paul R. Herold* 1-12-09  
Paul R. Herold Date:

License number 15525  
My license renewal date is December 31, 2008.  
Sheets covered by this seal: Individual sheet only

List Corners to be Indexed			
Corners	Section	Twp.	Range
SW-SE-NW	25	90	12
NE-SE-NW	25	90	12

Project Number: 2008-141

FB: Black Hawk County 1, Pgs. 1-2