

PROOF AD FILED FOR RECORD MAY 12, 2006, AT 4:00 P M. FEE N/CCOMPARED ADPatricia A. Deo

BLACK HAWK COUNTY RECORDER

ENGINEERS OFFICE

PREPARED BY: BLACK HAWK COUNTY ENGINEERS OFFICE
316 E. FIFTH STREET, ROOM 211 WATERLOO, IOWA 50703PH.# (319) 833-3008
FAX.# (319) 833-3139SLI 9-94
CERT 12-96

UNITED STATES PUBLIC LAND SURVEY CORNER CERTIFICATE OF
Land Survey Monuments situated in Section 25, Township 90 N,
Range 12 W, of the Fifth Principal Meridian, BLACK HAWK County, Iowa.
Previously recorded in Misc. Book N/A, Page N/A, in County Recorder's Office.

(Show reason for preparing this certificate, the evidence and detailed procedures used in establishing the corner positions and monumentation found or placed.)

Monument Description and Remarks: RECORD 1872 (J. BALL CO. SURVEYOR)
CALLED FOR "STONE" AT CORNER. WPA RECORDS DENOTED 12x6x2 LIMESTONE
ON 12/17/1941, AT DIST. DENOTED. FOUND OLD OAK HUB (PLUMB/TRUED) &
POINTED LIMESTONE (2"x3"x6") ALONG S. SIDE OF HUB, BEING LOCATED @
2.2' DEEP. HELD HUB, AND SET MAG NAIL IN TOP OF HUB AND A #5 RBR.
ALONG NE FACE OF HUB @ 3" BELOW HUB. EST. 2' Lx#5 RBR WITH 2" ALUM.
CAP STAMPED "BLACK HAWK COUNTY LAND CORNER" @ ±2" BELOW RD. SURFACE.
ROAD/R.O.W. VACATED, AND TIED FOR RECORD TO REF. ORIGINAL 1872 SURVEY.

PLAN - VIEW


(Show a minimum of three reference ties to durable physical objects, relevant monuments and physical conditions that will enable recovery of the corner.)

NOTE:


ALL TIE DISTANCES PER EDM MEAS. (H.D.)

DEFL. ANGLE CALC. PER RADIAL MEAS.

NOT TO SCALE

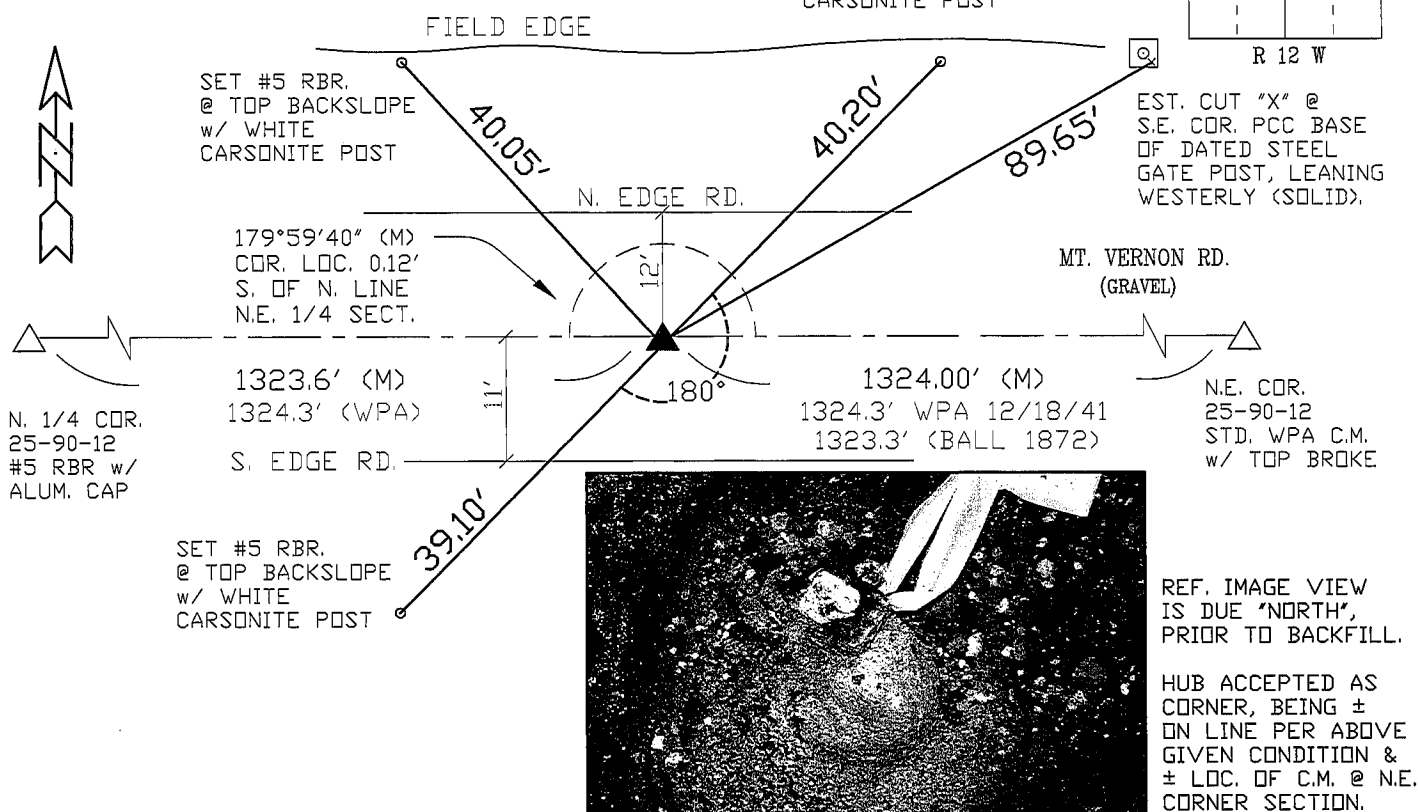FIELD SURVEY: G.T. & C.W. 05/02/06
PREPARED BY: G. TINKER 05/11/06

CERTIFICATION

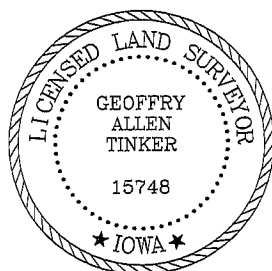

I hereby certify that this land surveying document was prepared and the related survey work was performed by me or under my direct personal supervision and that I am a duly licensed Land Surveyor under the laws of the State of Iowa.

Geoffrey Allen Tinker May 11th, 2006 (date)

License Number 15748My license renewal date is December 31, 2006

Pages or sheets covered by this seal:

This Land Corner Certificate Only.

LIST CORNERS TO BE INDEXED

Corner	Section	Township	Range
NE. COR.	25	90 N	12 W
NW1/4-NE1/4			
SE. COR.	24	90 N	12 W
SW1/4-SE1/4			