

WJS

INDEX RS BLACK HAWK COUNTY, IOWA:ss

FEE BOOK # 2006 27274

PROOF

FILED FOR RECORD MAY 12

2006

AT 4:00 P

M. FEE N/C

COMPARED

Geoffrey Allen Tinker

BLACK HAWK COUNTY RECORDER

ENGINEERS OFFICES

PREPARED BY: BLACK HAWK COUNTY ENGINEERS OFFICE
316 E. FIFTH STREET, ROOM 211 WATERLOO, IOWA 50703PH.# (319) 833-3008
FAX.# (319) 833-3139SLSI 9-94
CERT 12-96

UNITED STATES PUBLIC LAND SURVEY CORNER CERTIFICATE OF
Land Survey Monuments situated in Section 25, Township 90 N,
Range 12 W, of the Fifth Principal Meridian, BLACK HAWK County, Iowa.
Previously recorded in Misc. Book N/A, Page N/A, in County Recorder's Office.

(Show reason for preparing this certificate, the evidence and detailed procedures used in establishing the corner positions and monumentation found or placed.)

Monument Description and Remarks: REF. RECORD WPA TIES, & EXCAVATED TO FND. REMNANT HUB w/ NAIL. TEMP. REF. AND EXCAVATED TO FND. STD. WPA C.M. LOC. 1.4' DEEP (BEING FLUSH WITH TOP OF RCB), AND LOCATED 0.3' EAST OF EAST EDGE 2'x2' RCB. CORNER UTILIZED FOR RECOVERY OF N.E. CORNER OF SECTION. MEAS. DEFLECTION PER RTK GPS. SET #5 RBR. w/ 2" ALUM. CAP STAMPED "BLACK HAWK COUNTY LAND CORNER" OVER TOP OF FND. C.M., WITH CAP LOC. ±2" BELOW ROAD SURFACE.

PLAN - VIEW


(Show a minimum of three reference ties to durable physical objects, relevant monuments and physical conditions that will enable recovery of the corner.)

NOT TO SCALE


NOTE:

ALL TIE DISTANCES PER EDM MEAS. (H.D.)

DEFL. ANGLE PER RTK GPS MEASURE

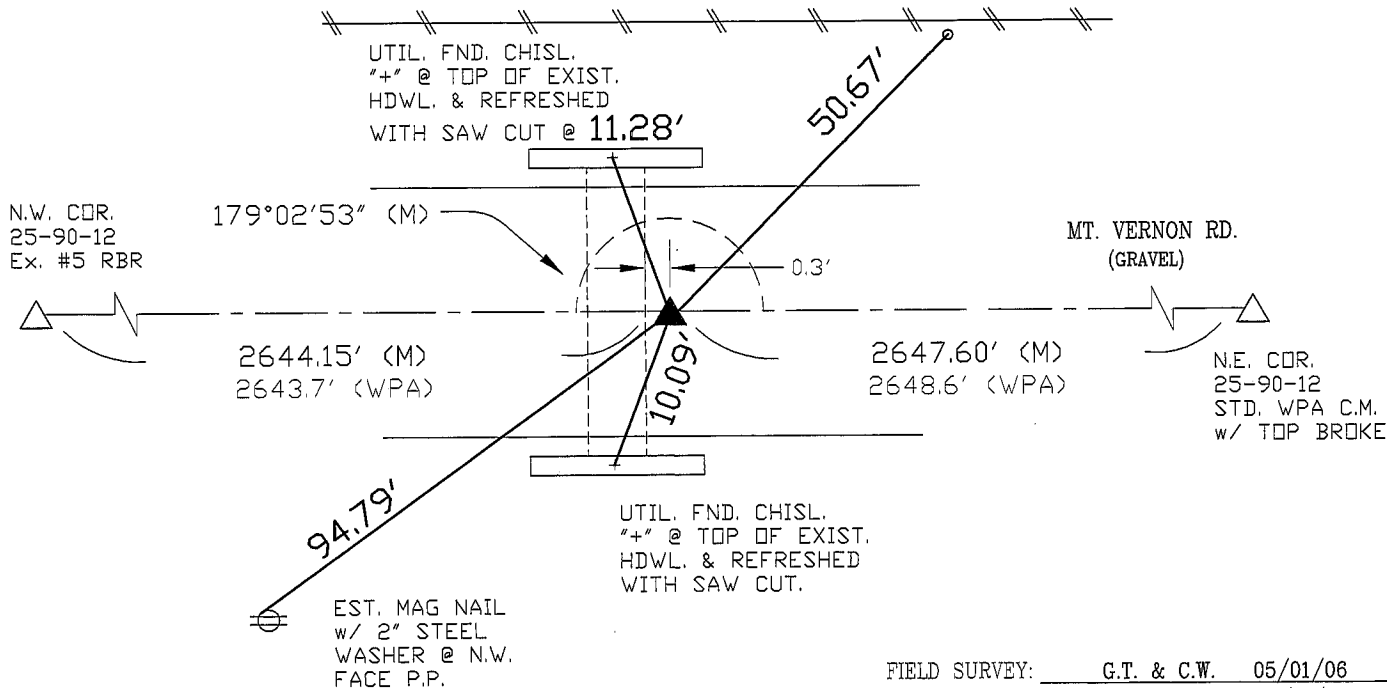STEEL WASHERS (1-1/2" Dia.) STAMPED
"BLACK HAWK CO. LAND CORNER TIE"SET #5 RBR.
@ 1' S. OF N.
R.O.W. FENCE
w/ WHITE
CARSONITE POSTFIELD SURVEY: G.T. & C.W. 05/01/06
PREPARED BY: G. TINKER 05/11/06

CERTIFICATION

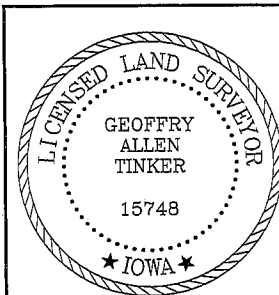

I hereby certify that this land surveying document was prepared and the related survey work was performed by me or under my direct personal supervision and that I am a duly licensed Land Surveyor under the laws of the State of Iowa.

Geoffrey Allen Tinker 05/11/2006
(date)

License Number 15748

My license renewal date is December 31, 2006

Pages or sheets covered by this seal:

This Land Corner Certificate Only.

LIST CORNERS TO BE INDEXED

Corner	Section	Township	Range
N. 1/4	25	90 N	12 W
S. 1/4	24	90 N	12 W