INDEX #5 BLACK HAWK COUNTY, IOWA:ss FEE BOOK # 20 06 27273

COMPARED

FILED FOR RECORD MAY 12

2006 AT 4:00 P M.

BLACK HAWK COUNTY RECORDER

ENGINEERS OFFICE

BLACK HAWK COUNTY ENGINEERS OFFICE

PH.# (319) 833-3008 FAX.# (319) 833-3139

SLSI 9-94 CERT 12-96

PREPARED BY:

316 E. FIFTH STREET, ROOM 211

WATERLOO, IOWA 50703

UNITED STATES PUBLIC LAND SURVEY CORNER CERTIFICATE OF


Land Survey Monuments situated in Section_ Range 12 W , of the Fifth Principal Meridian, BLACK HAWK County, Iowa. Previously recorded in Misc. Book N/A, Page N/A, in County Recorder's Office.

(Show reason for preparing this certificate, the evidence and detailed procedures used in establishing the corner positions and monumentation found or placed.)

Monument Description and Remarks: <u>NORTHEAST CORNER SECTION 25-90-12</u> FOUND STD, WPA C.M. w/ TOP BROKE PER DIST./DIST, INTERSECTION OF WPA NOTE WPA N/S DIST. TO E. 1/4 COR. SECT. 24-90-12. RECORD MEASURE, $\pm 2'$ L. OF MONUMENT REMAINS (PROBED), w/ MONUMENT FND. TIPPED SLIGHTLY RBR. ALONG N. FACE OF C.M., WITH CORNER LOC. IN TOE F.S. AND SET WITNESS REFERENCED CENTER OF C.M. AS FOUND, CORNERS 20.00' W. & N. FROM CORNER, AS DENOTED. VACATED R.O.W./

PLAN - VIEW

(Show a minimum of three reference ties to durable physical objects, relevant monuments and physical conditions

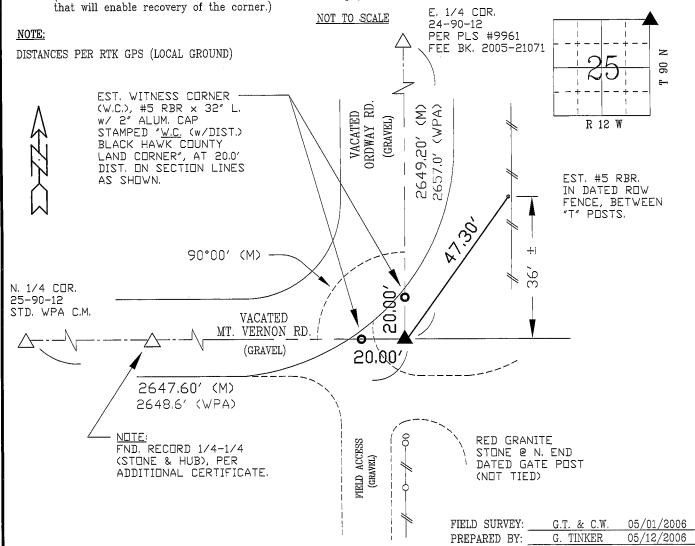

CERTIFICATION

I hereby certify that this land surveying document was prepared and the related survey work was performed by me or under my direct personal supervision and that I am a duly licensed Land Surveyor under the laws of the State of Iowa.



Tein

15748

My license renewal date is December 31,

Pages or sheets covered by this seal:

This Land Corner Certificate Only

LIST CORNERS TO BE INDEXED

ı									
	<u>Corner</u>		<u>Section</u>	- <u>Township</u>		- <u>Range</u>			
	N.E.	COR.	25		90	N		12	W
	N.W.	COR.	30		90	N		11	W
	S.E.	COR.	24		90	N		12	W
	S.W.	COR.	19		90	N		11	W