Document Number: 2007001457

Date: Jul 19, 2006 2:17:54 pm

0.00 Aud Fee:

Rec Fee: 0.00

0.00

 \mathbf{Z}

0.00 Rec Management Fee: Non-Standard Page Fee: E-Com Fee: 0.00 0.00

Filed for record in Black Hawk County, Iowa Patricia S. Sass, County Recorder

BLACK HAWK COUNTY ENGINEERS OFFICE 316 E. FIFTH STREET, ROOM 211 WATE PREPARED BY: WATERLOO, IOWA

PH.# (319) 833-3008 FAX.# (319) 833-3139

SLSI 9-94 CERT 12-96

UNITED STATES PUBLIC LAND SURVEY CORNER CERTIFICATE OF


Land Survey Monuments situated in Section_ 26 _, Township_ Range 12 W , of the Fifth Principal Meridian, BLACK HAWK County, Iowa. Previously recorded in Misc. Book n/a, Page n/a, in County Recorder's Office.

(Show reason for preparing this certificate, the evidence and detailed procedures used in establishing the corner positions and monumentation found or placed.)


Monument Description and Remarks: FND. #5 RBR. PRIOR TO RESURF. PROJECT, AND TIED AS SHOWN WITH PLAN 41/2"-5" HMA RESURF, PROPOSED. GEOM. DEFL. AND SECTION LINE REFERENCES PER RTK GPS MEAS., 1999/2000 MAPPING PROJECT. RE-SET WITH 5IN, L. #5 REBAR LOCATED 0.10' EAST OF C.L. ACC JOINT

PLAN - VIEW

(Show a minimum of three reference ties to durable physical objects, relevant monuments and physical conditions that will enable recovery of the corner.)

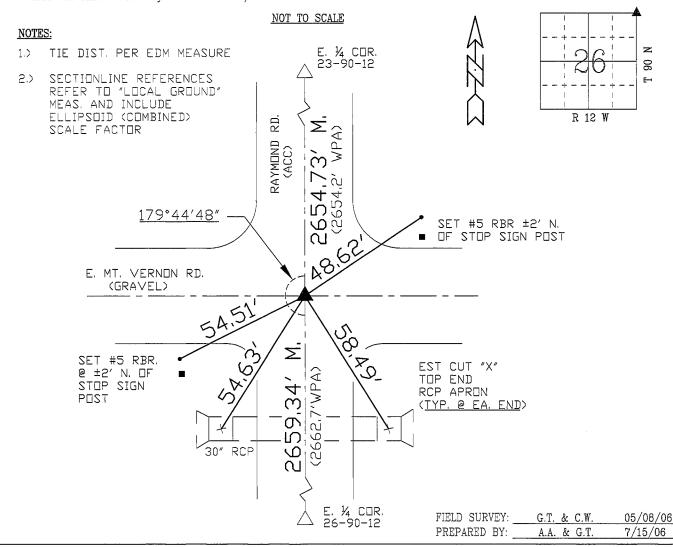

CERTIFICATION

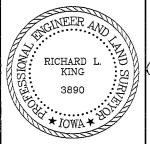

I hereby certify that this land surveying document was prepared and the related survey work was performed by me or under my direct personal supervision and that I am a duly licensed Land Surveyor under the laws of the State of Iowa.

My license renewal date is December 31, 2007

Pages or sheets covered by this seal: This Land Corner Certificate Only

LIST CORNERS TO BE INDEXED

<u>Corner</u>	<u>Section</u> -	Township	- <u>Range</u>
N.E COR	26	90 N	12 W
S.E. COR	23	90 N	12 W
N.W. COR	25	90 N	12 W
S.W. COR	24	90 N	12 W