

SC
MISC
INDEX 11
MARGIN
PROOF
COMPARE

BLACK HAWK COUNTY IOWA:SS
FILED FOR RECORD JUNE 16, 1999 AT
4:00 P. M. AND RECORDED IN BOOK 334
OF MISC- PAGE 803.
Wayne Claassen RECORDER
FEE 1-5.00/
WAYNE CLAASSEN ENGINEERING & SURVEYING

WAYNE CLAASSEN ENGINEERING AND SURVEYING, INC.
P.O. BOX 898 WATERLOO, IOWA 50704-0898

PHONE: (VOICE) 319-235-6294
(FAX) 319-235-0028

UNITED STATES PUBLIC LAND SURVEY CORNER CERTIFICATE


Land Survey Monuments situated in Section 29, Township 90N, Range 12W, of the Fifth Principal Meridian, BLACK HAWK County, Iowa.
Previously recorded in N/A in County Recorder's Office.
(book, page, document number, etc.)

(Show reason for preparing this certificate, the evidence and detailed procedures used in establishing the corner positions and monumentation found or placed.)

Monument Description and Remarks SET 1/2" X 21" REBAR & CAP NO. 8033 AT INTERSECTION E-W
1/4 COR. LINE & N-S 1/4 LINES. NO FENCE CORNER (SEE SKETCH) (CENTER SEC 29)

PLAN - VIEW

(Show a minimum of three reference ties to durable physical objects, relevant monuments and physical conditions that will enable recovery of the corner.)

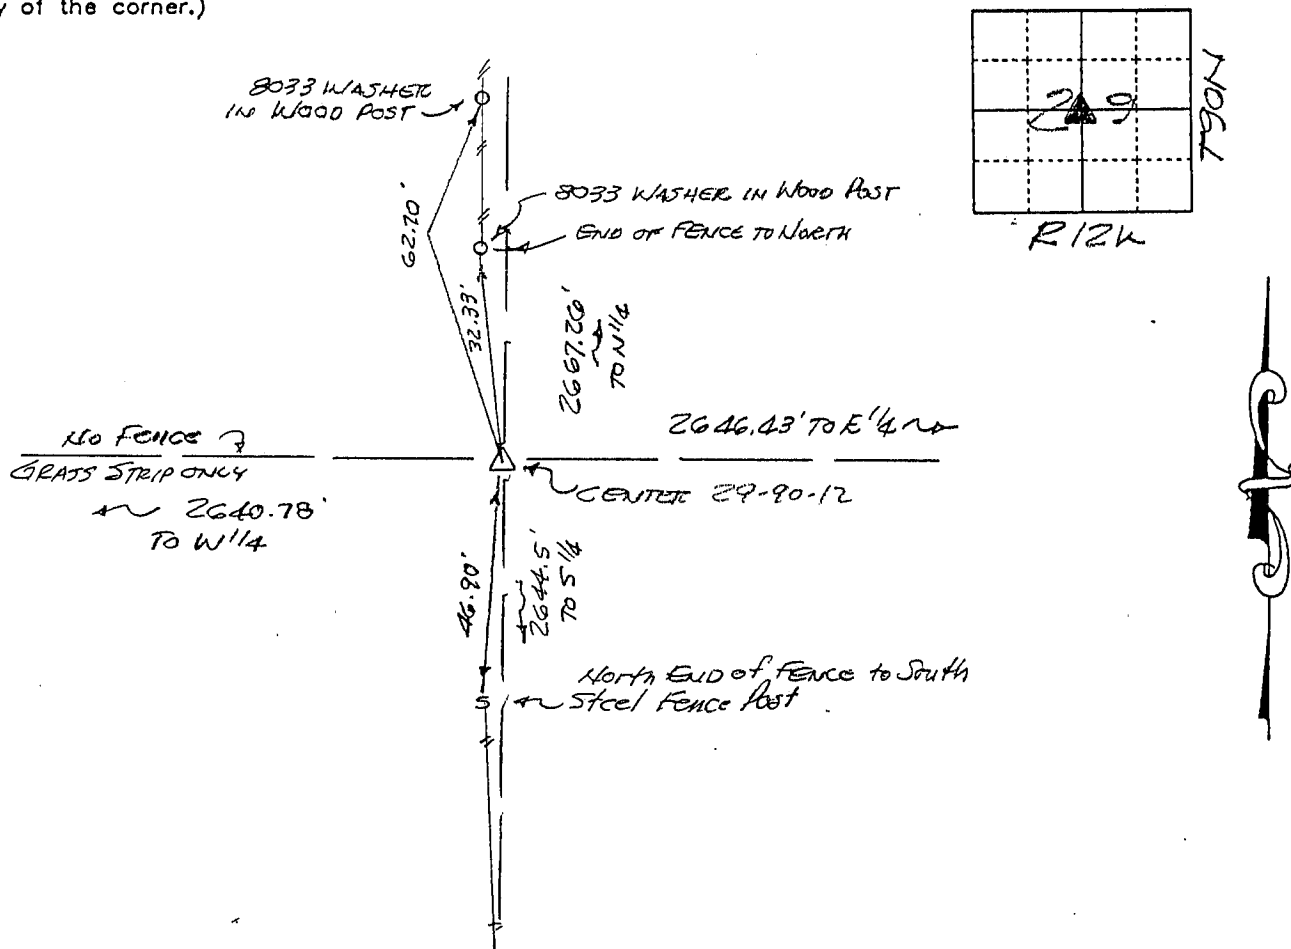

497-53

I hereby certify that the survey work was completed and this certificate was prepared by me or under my direct personal supervision and that I am a duly licensed land surveyor under the laws of the state of Iowa.


Signature:

(Name typed or printed:) F. WILLIAM KING

Date: JUNE 14, 1999

Lic. No. 8033

SEAL

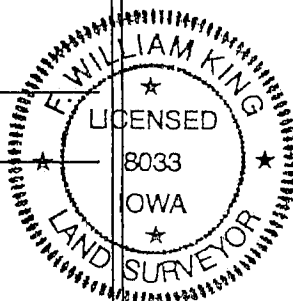

List Corners to be Indexed

Corners	Section	Twp	Range
CENTER	29	90N	12W

BOOK 334 PAGE 803