

SC
MISC
INDEX 2
MARGIN
PROOF
COMPARE

024002

FILED FOR RECORD May 19, 2000 AT
4:00 P. M., AND RECORDED IN BOOK 338
OF MISC PAGE 404
Patricia A. Less RECORDER
FEE 1-5.00/
PAUL HELLAND

Paul H. Helland, 1107 Technology Parkway, Cedar Falls, Iowa 50613-6951, (319)-266-0161

UNITED STATES PUBLIC LAND SURVEY CORNER CERTIFICATE OF

LAND SURVEY MONUMENTS SITUATED IN SECTION NO. 1, TOWNSHIP NO. 90 NORTH, RANGE
NO. 13 WEST OF THE FIFTH PRINCIPAL MERIDIAN, BLACK HAWK COUNTY, IOWA.

PREVIOUSLY RECORDED IN BOOK _____, PAGE _____.

(SHOW REASON FOR PREPARING THIS CERTIFICATE, THE EVIDENCE AND DETAILED PROCEDURES USED IN ESTABLISHING THE
CORNER POSITIONS AND MONUMENTATION FOUND OR PLACED.)

MONUMENT DESCRIPTION AND REMARKS:

SURVEY DONE IN NE 1/4 SE 1/4 OF SEC. 1-T90N-R13W.


CENTER: Found stone w/point 1.7' deep 0.25' West of No. 4 rebar found 1.3' deep, set No. 4 rebar w/orange cap #6505
above stone.

E 1/4 CORNER: Found 5/8" smooth sided pin above a concrete monument w/brass cap, found C.M. 3' deep.

SE CORNER: Found concrete monument w/brass cap 1.2' deep, set No. 4 rebar w/orange cap #6505 (6" long) above C.M.

PLAN VIEW

(SHOW A MINIMUM OF THREE REFERENCE TIES TO DURABLE PHYSICAL OBJECTS, RELEVANT MONUMENTS AND PHYSICAL
CONDITIONS THAT WILL ENABLE RECOVERY OF THE CORNER.)

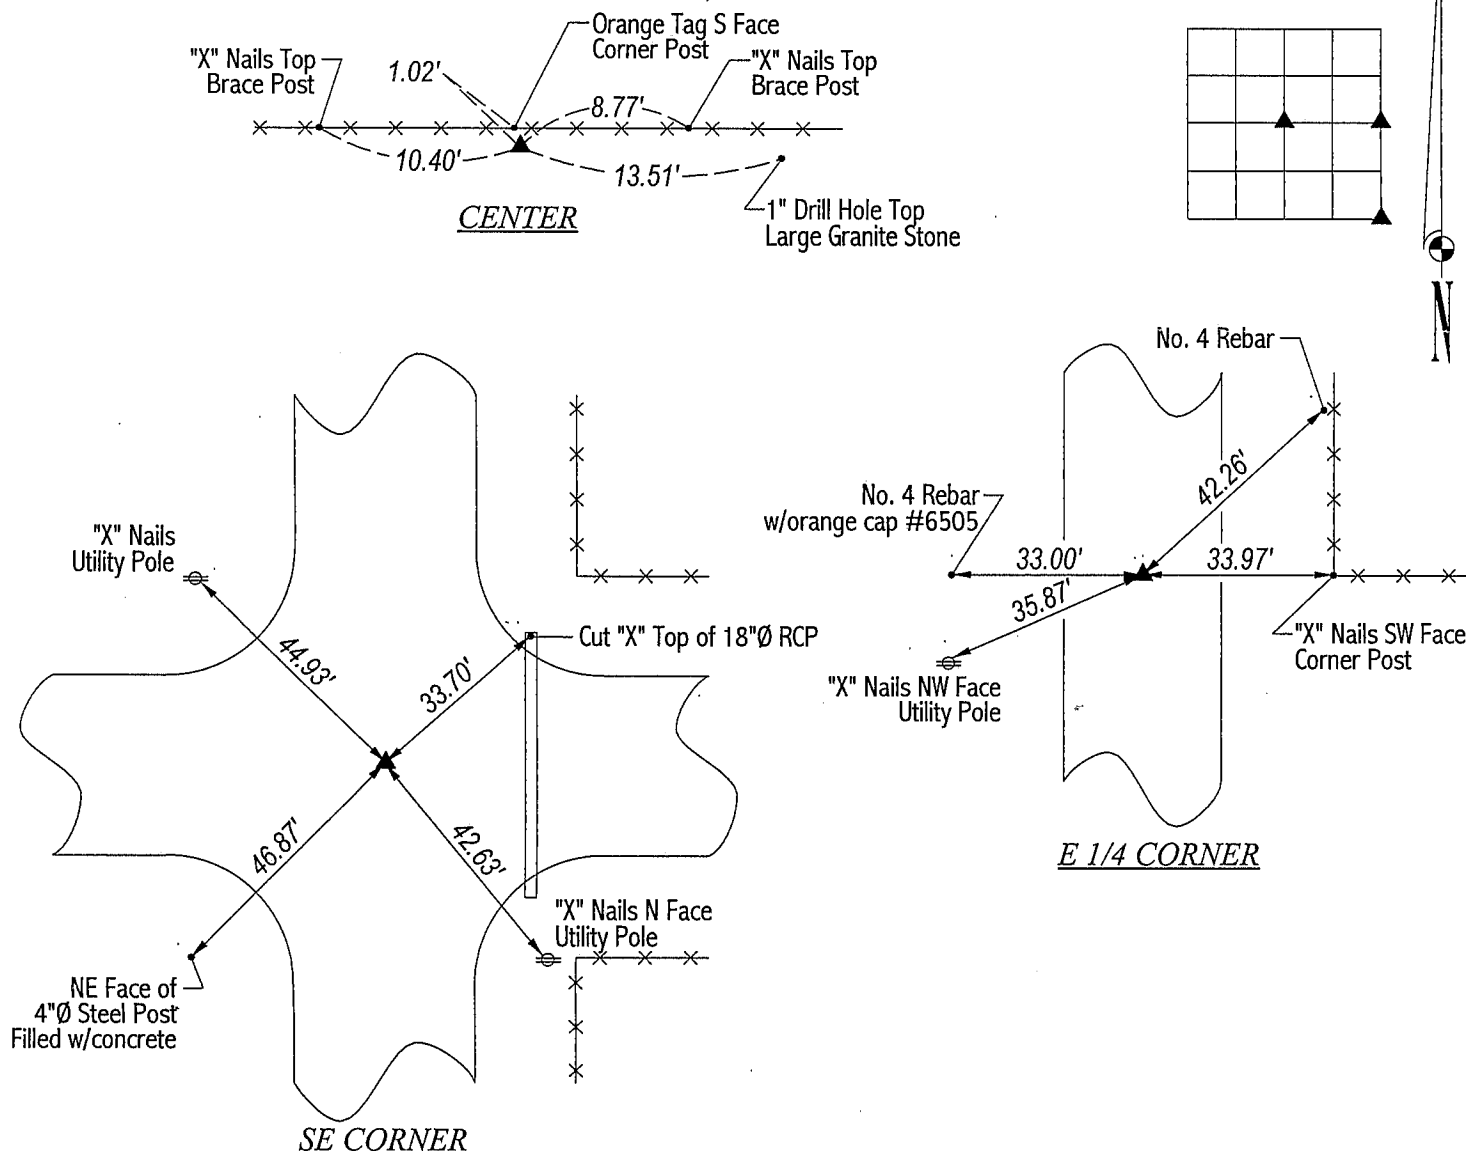

HELLAND ENGINEERING & SURVEYING, LTD.
1107 Technology Parkway
Cedar Falls, Iowa 50613-6951
(319)-266-0161

FILE NAME: 00-149CC.DRG



I hereby certify that this land surveying document was prepared
and the related survey work was performed by me or under my
direct personal supervision and that I am a duly licensed Land
Surveyor under the laws of the State of Iowa.

Paul H. Helland 5/31/00
Paul H. Helland
License Number 6505
My license renewal date is December 31, 2001.
All pages or sheets are covered by this seal except:

LIST CORNERS TO BE INDEXED			
CORNER	SECTION	TOWNSHIP	RANGE
CENTER	1	90N	13W
E 1/4 CORNER	1	90N	13W
SE CORNER	1	90N	13W

Re 338 404