

Doc ID: 006860950001 Type: GEN Recorded: 09/14/2015 at 12:29:33 PM Fee Amt: \$7.00 Page 1 of 1 Black Hawk County Iowa SANDIE L. SMITH RECORDER File 2016-0005062

🖹 Prepared by & Return to: Herold - Reicks Surveying, 2206 East Bremer Avenue, Waverly, IA 50677, Ph. 319-483-5187

## UNITED STATES PUBLIC LAND SURVEY CORNER CERTIFICATE

Land Survey Monuments situated in Section 1, Township 90 North, Range 13 West of the Fifth Principal Meridian, Black Hawk County, Iowa. Previously recorded in Document #2005-10084 in the County Recorder's office.

This certificate is being prepared in compliance with Iowa Code Chapter 355.11 because:

There is no certificate on file for this corner. X There are no longer three valid ties of record.

X There are changes to reference ties of record.

X There is change of monumentation of record.


 $\Box$ To clarify description of record monument (ties).

Monument Description and Remarks:

West 1/4 Corner: Found survey mark nail with stainless steel washer "IDOT" with information obtained from the previous Section Corner Certificate, Document #2005-10084.

## PLAN - VIEW

(Show a minimum of three reference ties to durable physical objects, relevant monuments and physical conditions that will enable recovery of the corner.)

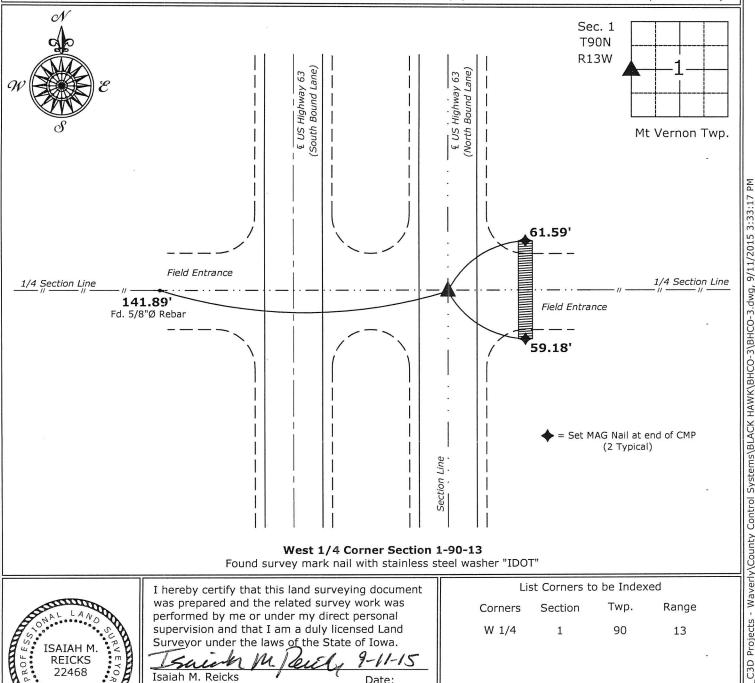

Found survey mark nail with stainless steel washer "IDOT"



I hereby certify that this land surveying document was prepared and the related survey work was performed by me or under my direct personal supervision and that I am a duly licensed Land Surveyor under the laws of the State of Iowa.

M Said leu Isaiah M. Reicks Date:

License number 22468

My license renewal date is December 31, 2015. Sheets covered by this seal: Individual sheet only

	List	Corners	to b	e Index	kea
Corners	;	Section		Twp.	Range

W 1/4 90 1 13

Project Number: 2015-351 FB: Black Hawk 10, Pgs. 4-5