

PROOF FILED FOR RECORD DEC 19, 2002, AT 4:00 P.M. FEE 1-5.00X

COMPARED

Paul H. Helland

BLACK HAWK COUNTY RECORDER

HELLAND ENGINEERING 1107 TECHNOLOGY PKWY CEDAR FALLS IA 50613-6951

Paul H. Helland, 1107 Technology Parkway, Cedar Falls, Iowa 50613-6951, (319)-266-0161

UNITED STATES PUBLIC LAND SURVEY CORNER CERTIFICATE
OFLAND SURVEY MONUMENTS SITUATED IN SECTION NO. 3, TOWNSHIP NO. 90 NORTH, RANGE
NO. 13 WEST OF THE FIFTH PRINCIPAL MERIDIAN, BLACK HAWK COUNTY, IOWA.

PREVIOUSLY RECORDED IN BOOK _____, PAGE _____.

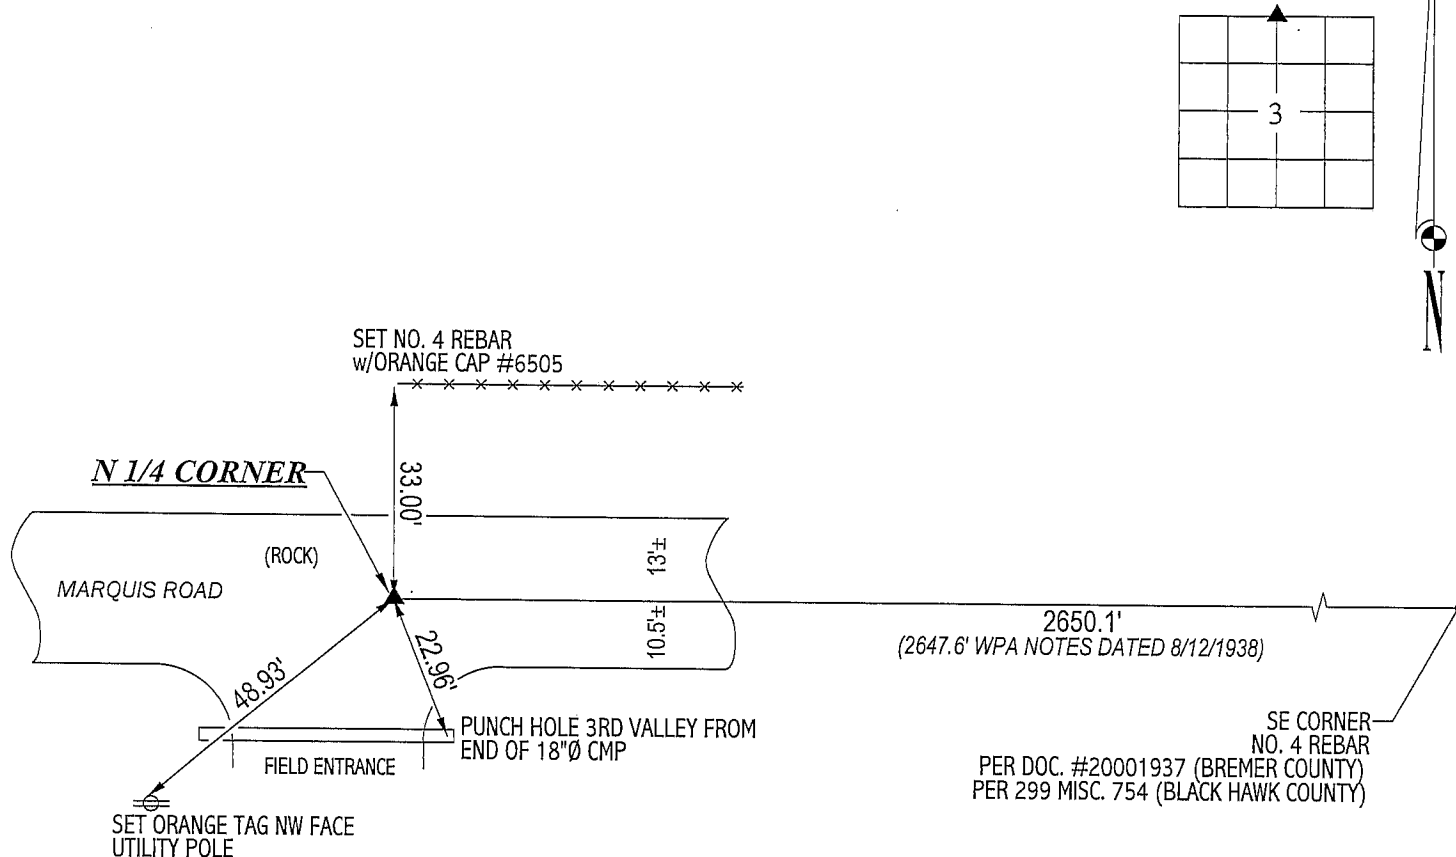
(SHOW REASON FOR PREPARING THIS CERTIFICATE, THE EVIDENCE AND DETAILED PROCEDURES USED IN ESTABLISHING THE
CORNER POSITIONS AND MONUMENTATION FOUND OR PLACED.)

MONUMENT DESCRIPTION AND REMARKS:

NO CORNER CERTIFICATE ON FILE. SURVEY DONE IN E 1/2 OF SEC. 34-T91N-R13W.

→ N 1/4 CORNER: ALL BREMER & BLACK HAWK COUNTY ENGINEER REFERENCE TIES OBLITERATED. POSITION RUN IN FROM PLAT OF SURVEY
DOC. #2002 4555 (BREMER COUNTY) AND EXCAVATION STARTED. FOUND CONCRETE MONUMENT w/BRASS CAP 1.0' DEEP w/MAGNETIC
DETECTION ON SOUTH SIDE. SET NO. 4 REBAR ("L-SHAPED" & 1' LONG) w/ORANGE CAP #6505 ABOVE CONCRETE MONUMENT.

PLAN VIEW

(SHOW A MINIMUM OF THREE REFERENCE TIES TO DURABLE PHYSICAL OBJECTS, RELEVANT MONUMENTS AND PHYSICAL
CONDITIONS THAT WILL ENABLE RECOVERY OF THE CORNER.)HELLAND ENGINEERING & SURVEYING, LTD.
1107 Technology Parkway
Cedar Falls, Iowa 50613-6951
(319)-266-0161

FILE NAME: 02-336C3.DRG

I hereby certify that this land surveying document was prepared
and the related survey work was performed by me or under my
direct personal supervision and that I am a duly licensed Land
Surveyor under the laws of the State of Iowa.*Paul H. Helland* 12/19/02
Paul H. Helland
License Number 6505
My license renewal date is December 31, 2003.
All pages or sheets are covered by this seal except:LIST CORNERS TO BE INDEXED
CORNER SECTION TOWNSHIP RANGE
N 1/4 CORNER 3 90N 13W*Rec.*