

* PREPARED BY / RETURN TO: KENNETH D. STARK IOWA DEPARTMENT OF TRANSPORTATION 1420 4th ST. SE MASON CITY, IA 50401 641-423-7584

UNITED STATES PUBLIC LAND SURVEY CORNER CERTIFICATE
OF

Land Survey Monuments situated in Section 07, Township 90N, Range 13W
of the Fifth Principal Meridian, BLACK HAWK County, Iowa.

Previously recorded in NA in County Recorder's Office.
(book, page, document number, etc.)


(Show reason for preparing this certificate, the evidence and detailed procedures used in establishing the corner positions and monumentation found or placed.)

Monument Description and Remarks: NW CORNER: FOUND 1/2" IRON PIN 6" DEEP ON GRESHAM
RD. AND BIG WOODS RD. USING IDOT INFORMATION OF RECORD. REASON FOR CERT NO CERT OF
RECORD AND UPDAING IDOT RECORDS.

W 1/4 CORNER: FOUND 1 1/2" PINCHED PIPE, 6" DEEP C BIG WOODS RD. USING IDOT INFORMATION
OF RECORD. REASON FOR CERT NO CERT OF RECORD AND UPDATING IDOT RECORDS.

PLAN - VIEW

(Show a minimum of three reference ties to durable physical objects, relevant monuments and physical conditions that will enable recovery of the corner.)

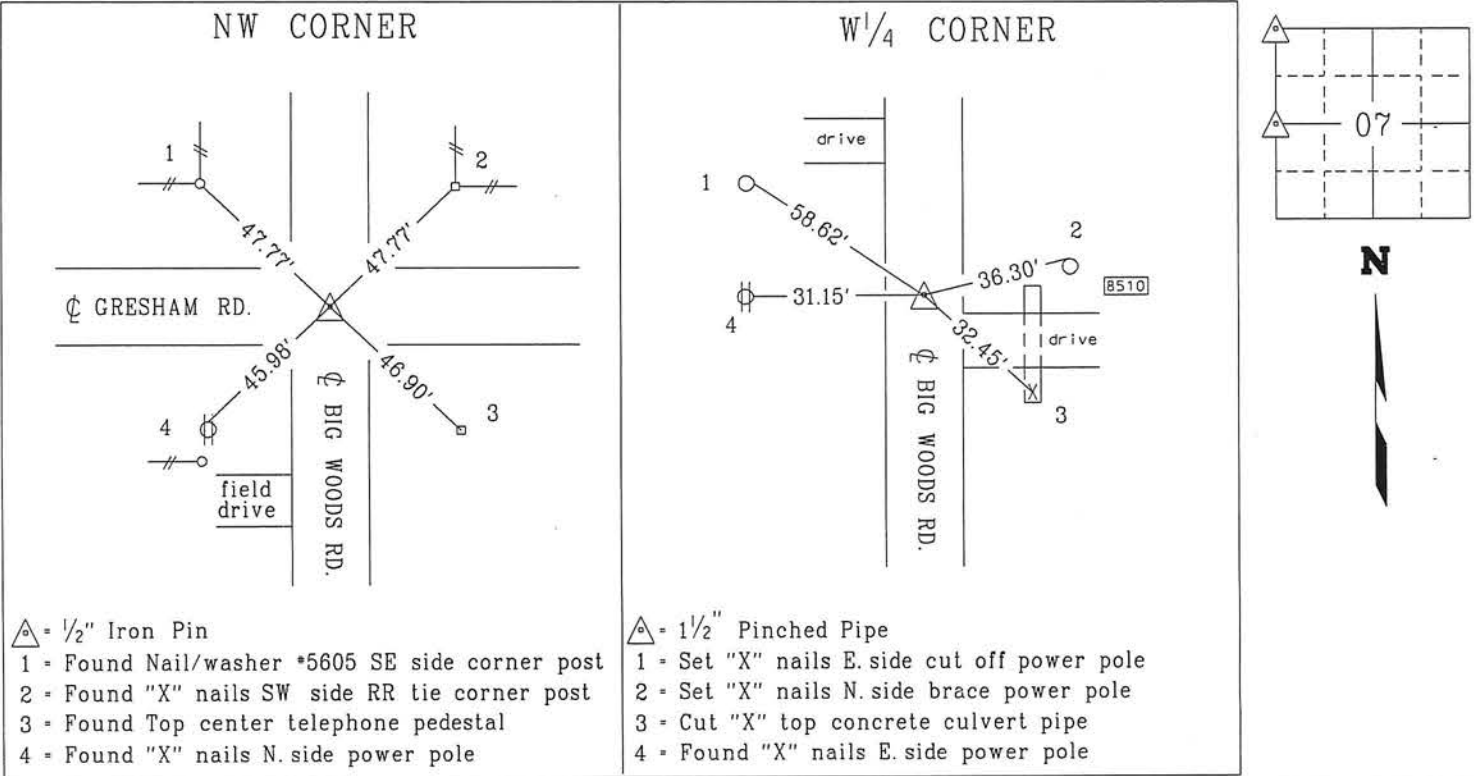

PROFESSIONAL LAND SURVEYOR
KENNETH D. STARK
10898
IOWA

I hereby certify that this land surveying document was prepared and the related survey work was performed by me or under my personal supervision and that I am duly licensed Land Surveyor under the laws of the state of Iowa.
Kenneth D. Stark Date 09-10-15
Kenneth D. Stark
License number 10898
My License renewal date is December 31, 2015
Pages or sheets covered by this seal. 1

List Corners to be Indexed			
Corner	Section	Township	Range
NW CORNER	07	90N	13W
W 1/4 CORNER	07	90N	13W

drawn by: c/s 7/12
tied by: me.cs
right-of-way

07-07-90-13

7002