

Document Number: 2008022744
Date: May 15, 2008 4:30:00 pm
Aud Fee: 0.00 Rec Fee: 5.00
Trans Tax: 0.00 Rec Management Fee: 1.00
E-Com Fee: 1.00 Non-Standard Page Fee: 0.00
Filed for record in Black Hawk County, Iowa
Judith A. McCarthy, County Recorder
PHONE: (VOICE) 319-235-6294
(FAX) 319-235-0028

WAYNE CLAASSEN ENGINEERING AND SURVEYING, INC.
P.O. BOX 898 WATERLOO, IOWA 50704-0898

UNITED STATES PUBLIC LAND SURVEY CORNER CERTIFICATE

Land Survey Monuments situated in Section 09, Township 90 North, Range 13 West, of the Fifth Principal Meridian, Black Hawk County, Iowa.
Previously recorded in _____ in County Recorder's Office.
(book, page, document number, etc.)


(Show reason for preparing this certificate, the evidence and detailed procedures used in establishing the corner positions and monumentation found or placed.)

Monument Description and Remarks

Center: No corner certificate on file. Set "X" cut in Northwest corner of 10"x10" concrete base at intersection of line from North 1/4 Corner to South 1/4 Corner with line from East 1/4 Corner to West 1/4 Corner.
SW Corner, NW 1/4 SE 1/4, Set 1/2"x24" steel re-bar and red cap #16775 at midpoint between S 1/4 Corner and Center of Section.
NE Corner, NW 1/4 SE 1/4, Set 1/2"x24" steel re-bar and red cap #16775 at midpoint between E 1/4 Corner and Center of Section.
SE Corner, NW 1/4 SE 1/4, Set 1/2"x24" steel re-bar and red cap #16775 at intersection of opposite 1/4-1/4 Section corners in the SE Quarter of Section 09.

PLAN - VIEW

(Show a minimum of three reference ties to durable physical objects, relevant monuments and physical conditions that will enable recovery of the corner.)

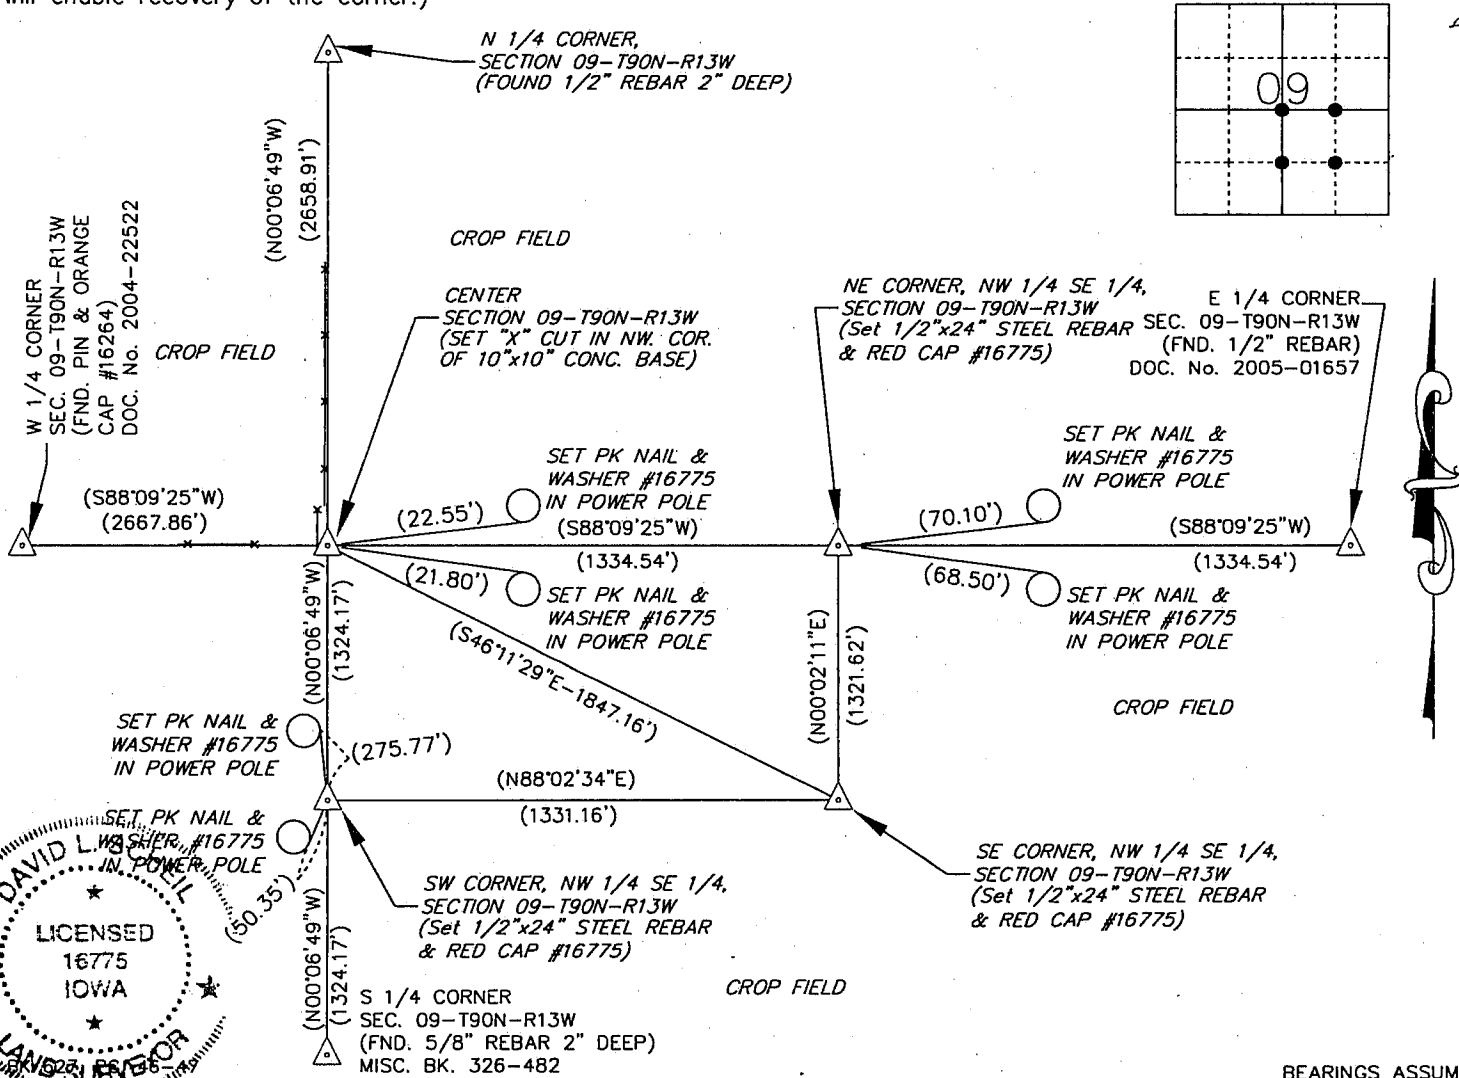

BEARINGS ASSUMED

I hereby certify that this land surveying document was prepared and the related survey work was performed by me or under my direct personal supervision and that I am a duly Licensed Land Surveyor under the laws of the State of Iowa.

Signature: _____
David L. Scheil, L.S.

Date: May 01, 2008 Lic. No. 16775

Pages or Sheets Covered by this Seal: THIS SHEET ONLY.

My license renewal date is December 31, 2008

SEAL

List Corners to be Indexed

Corners	Section	Twp	Range
CENTER,	09	90 N	13 W
SW CORNER, NW 1/4, SE 1/4,	09	90 N	13 W
NE CORNER, NW 1/4, SE 1/4,	09	90 N	13 W
SE CORNER, NW 1/4, SE 1/4,	09	90 N	13 W