**REC FEE** E FEE TRAN FEE **REV FEE** GF

Doc ID: 005595310001 Type: GEN Recorded: 10/10/2014 at 01:07:00 PM Fee Amt: \$0.00 Page 1 of 1 Black Hawk County Iowa JUDITH A MCCARTHY RECORDER

File 2015-00006302

★ PREPARED BY:

BLACK HAWK COUNTY ENGINEERS OFFICE 316 E. FIFTH STREET, ROOM 211 WATE

WATERLOO, IOWA 50703

PH.# (319) 833-3008 FAX.# (319) 833-3139

SLSI 9-94 BHCO 03-09

UNITED STATES PUBLIC LAND SURVEY CORNER CERTIFICATE OF


Land Survey Monuments situated in Section\_\_\_\_ 9 , Township 90 N Range 13 W, of the Fifth Principal Meridian, BLACK HAWK County, Iowa.

Previously recorded in Fee Book 2005, Page 07353, in County Recorder's Office. (Show reason for preparing this certificate): The corner monument has been Replaced or Modified, per Ia. Code 355.11(1)(c)

(Evidence and detailed procedures used in establishing the corner position(s) and monumentation found or placed.)

Monument Description and Remarks: E. 1/4 COR.

CORNER RESET & TIES UPDATED FOR H.M.A. RESURF, PROJECT LFM-1307--7X-07. PRIOR TO RESURF, PROJECT, FOUND 1/2" (#4) Rbr. @ C.L. A.C.C. JOINT PER FEE BOOK# 2005-07353 AND TEMP, REF. COR. LOC. PER RTK GPS. AFTER 2" DP. MILL, NO SOUNDING REMAINED @ ± PRIOR\_TO RTK REFERENCE LOCATION, W/ NO FURTHER EXCAVATION. PVMNT. RESURFACED W/ +3.5"
(2" INT. & 1.5" SURF.) H.M.A. PAVING. AFTER H.M.A. RESURFACE, RESET CORNER WITH 6" L
MAG SPIKE W/ MTL. WASHER (PLS #15748) LOCATED @ ±0.20' WEST OF H.M.A. JOINT AND ALIGNED WITH EXISTING SOD FENCE TO WEST.

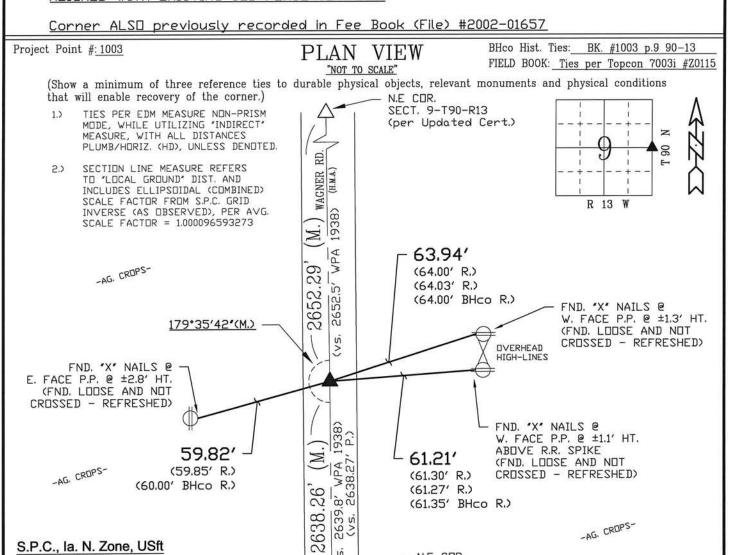

## CERTIFICATION



S.P.C., Ia. N. Zone, USft

CONVERGENCE = 0° 45' 40"

(NAD83-NA20II IARTN OBS.)

N = 3691664.14

E = 5223513.49

I hereby certify that this land surveying document was prepared and the related survey work was performed by me or under my direct personal supervision and that I am a duly licensed Land Surveyor under the laws of the State of Iowa.

(88)

N.E COR.

SECT. 16-T90-R13

(per Misc. 326 p. 482)

FIELD SURVEY:

PREPARED BY:

er Allen Tinker Geoffry

15748 License Number \_

My license renewal date is December 31, 2014

Pages or sheets covered by this seal:

This Land Corner Certificate Only.

LIST	CORNERS	TO	BE	INDEXE

Corner	Section -	Township -	Range
E. 1/4 Cor.	9	90 N	13 W
W. 1/4 Cor.	10	90 N	13 W

S.S. & G.T.

## INDEX OF ABBREVIATIONS

06/17/14

10/7/14

INDEX OF ABBREVIATIONS

= "Measured" Dimension = "Platted" Dimension = "Record" Dimension = "Calculated" Dimension = "Calculated" Dimension = "SM" = Survey Marker Spike/Tag SM = Borks Progress Admin. Survey

= per George Miller Survey (BHco Surveyor 1858-1860) = per John Ball Survey (BHco Surveyor 1908-1931)