

I

P

Z

Document Number: 2008022743

Date: May 15, 2008 4:30:00 pm

Aud Fee: 0.00 Rec Fee: 5.00

Trans Tax: 0.00 Rec Management Fee: 1.00

E-Com Fee: 1.00 Non-Standard Page Fee: 0.00

Filed for record in Black Hawk County, Iowa

Judith A. McCarthy, County Recorder

PHONE: (VOICE) 319-235-6294

(FAX) 319-235-0028

WAYNE CLAASSEN ENGINEERING AND SURVEYING, INC.
P.O. BOX 898 WATERLOO, IOWA 50704-0898

UNITED STATES PUBLIC LAND SURVEY CORNER CERTIFICATE

Land Survey Monuments situated in Section 09, Township 90 North, Range 13 West, of the Fifth Principal Meridian, Black Hawk County, Iowa.Previously recorded in _____ in County Recorder's Office.
(book, page, document number, etc.)


(Show reason for preparing this certificate, the evidence and detailed procedures used in establishing the corner positions and monumentation found or placed.)

Monument Description and Remarks _____

N 1/4 Corner: No corner certificate on file. Found 1/2" Rebar 2" deep in gravel road. WPA notes from BHC Engineer's Office (dated August 18, 1938) state the following: "found limestone 2 1/2" x 6 1/2" x 9" and 2 old bridge spikes, also pieces of stake. lowered stone and set C.M. on top 12" below ground." All reference ties from 1938 obliterated by widening of Gresham Road. Searched for C.M. in an area 1.5'-3.0' West of found rebar but did not find. Searched for C.M. underneath rebar but did not find.

PLAN - VIEW

(Show a minimum of three reference ties to durable physical objects, relevant monuments and physical conditions that will enable recovery of the corner.)

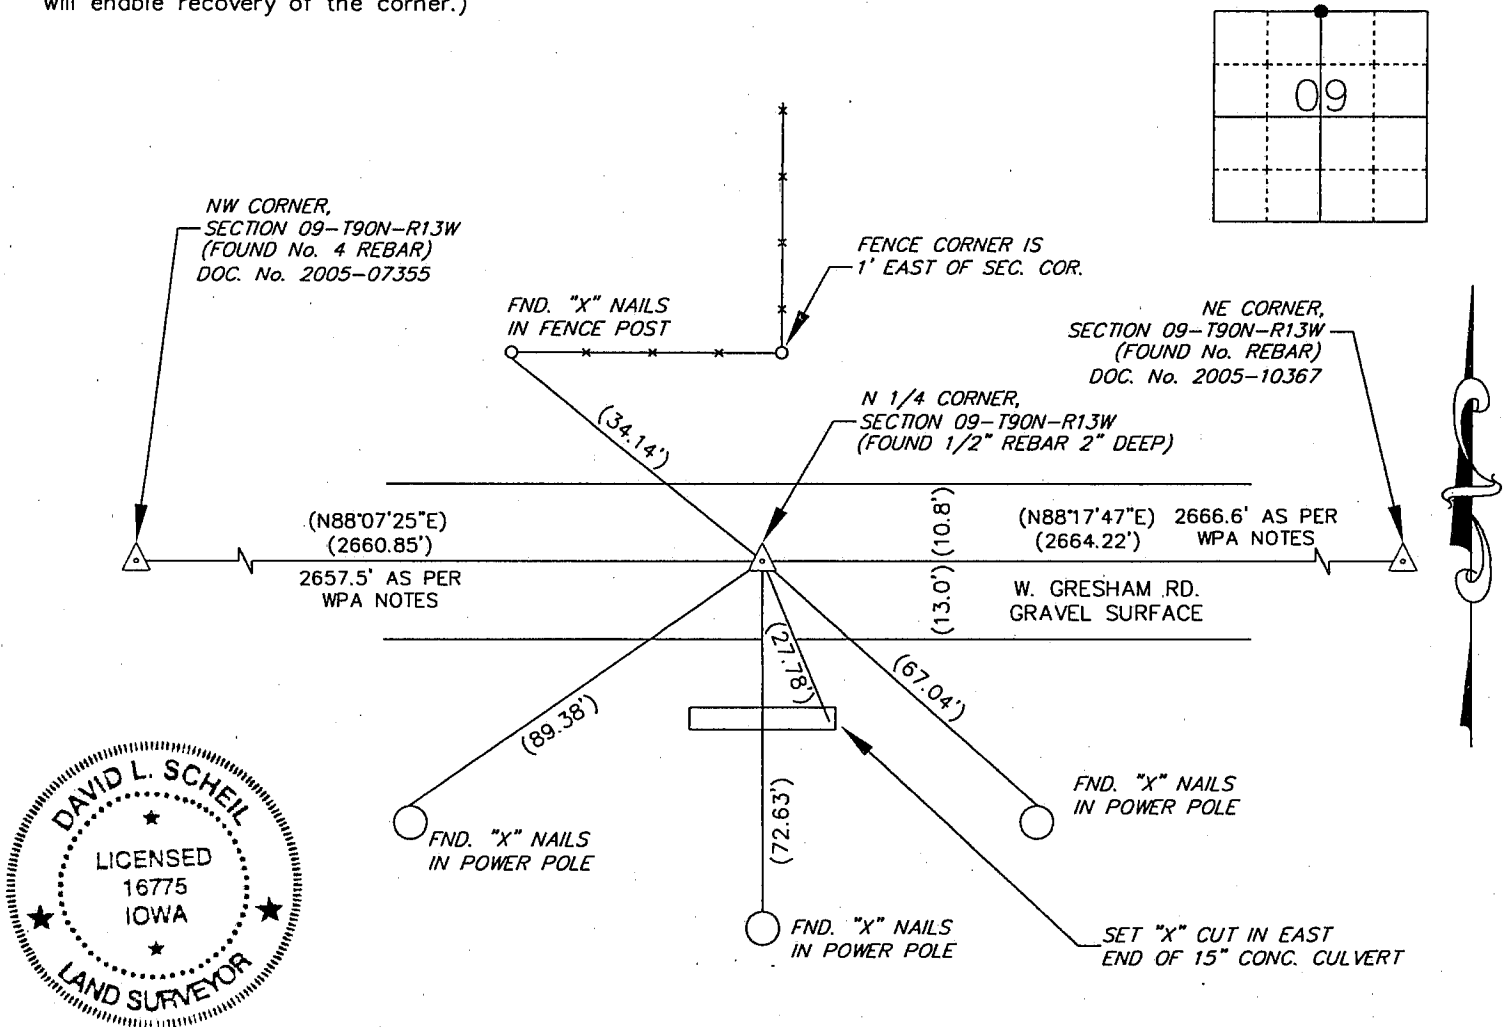

BK 627, PG. 43

BEARINGS ASSUMED

I hereby certify that this land surveying document was prepared and the related survey work was performed by me or under my direct personal supervision and that I am a duly Licensed Land Surveyor under the laws of the State of Iowa.

Signature: David L. Scheil
David L. Scheil, L.S.Date: May 07, 2008 Lic. No. 16775Pages or Sheets Covered by this Seal: THIS SHEET ONLY.

My license renewal date is December 31, 2008

SEAL

List Corners to be Indexed

Corners	Section	Twp	Range
N 1/4 CORNER,	09	90 N	13 W