

Recorded

SLSI 9-90

UNITED STATES PUBLIC LAND SURVEY CORNER CERTIFICATE




OF

Land Survey Monuments situated in Section 10, Township 90 N., Range 13 W., of the Fifth Principal Meridian, BLACK HAWK County, Iowa. Previously recorded in (not applicable) in County Recorder's Office.

(Show reason for preparing this certificate, the evidence and detailed procedures used in establishing the corner positions and monumentation found or placed.)
Monument Description and Remarks: FOUND 3/8" IRON BAR, SET NEW TIES.

PLAN - VIEW

(Show a minimum of three reference ties to durable physical objects, relevant monuments and physical conditions that will enable recovery of the corner.)

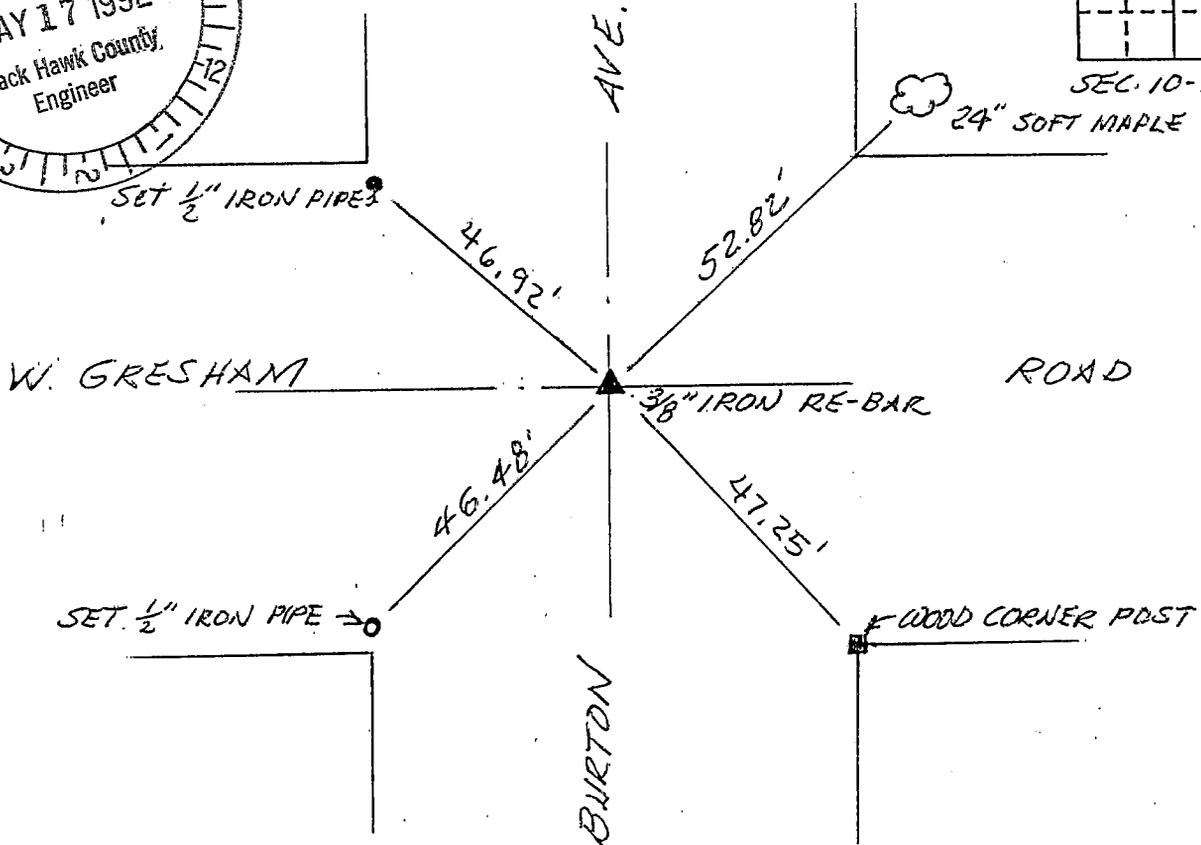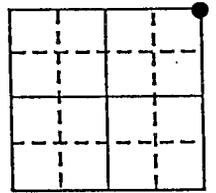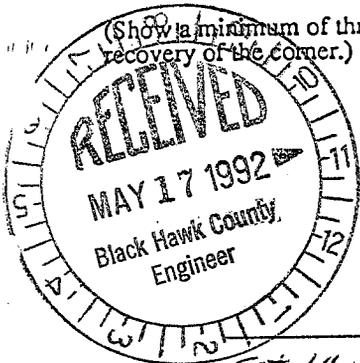

I hereby certify that the survey work was completed and this certificate was prepared by me or under my direct personal supervision and that I am a duly registered land surveyor under the laws of the state of Iowa.


Signature: Harold F. Michels

Name typed or printed: Harold F. Michels

Date: MAY 15, 92 Reg. No. 3862

Corners	List Corners to be Indexed		
	Section	Twp	Range
NE	10	90	13

SEAL

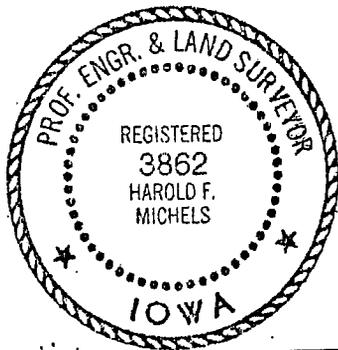

MISC. BK. 301 p. 304