

SC
MISC
INDEX 11
MARGIN
PROOF
COMPARE

BLACK HAWK COUNTY IOWA:SS
FILED FOR RECORD APR 18, 2001 AT
4:00 P. M. AND RECORDED IN BOOK 342
OF MISC PAGE 420

021260

Cathie J. Sess

RECORDER

FEE 1-5.00/
S & S LAND SURVEYING INC.
PO BOX 148
WAVERLY, IA 50677

PREPARED BY - S & S LAND SURVEYING, INC., 118 W BREMER AVE., PO BOX 148, WAVERLY, IOWA 50677 - PHONE 318-352-9444

UNITED STATES PUBLIC LAND SURVEY CORNER CERTIFICATE






OF

Land Survey Monuments situated in Section 11, Township 90 NORTH, Range 13 WEST of the Fifth Principal Meridian, BLACK HAWK County, Iowa.
Previously recorded in Book S 1/4 326 MISC., Page 484.

CORNERS WERE LOCATED FOR A LAND SURVEY IN THE S.E. 1/4, USING TIES OBTAINED FROM I.D.O.T. CORNERSTONE SURVEY. NEW CERTIFICATE IS BEING PREPARED FOR S 1/4 CORNER DUE TO CHANGES IN PHYSICAL CONDITIONS AROUND CORNER.

PLAN-VIEW

NO SCALE

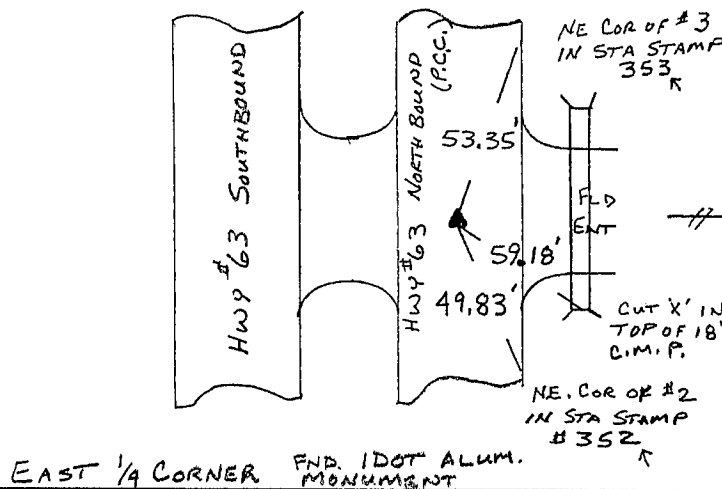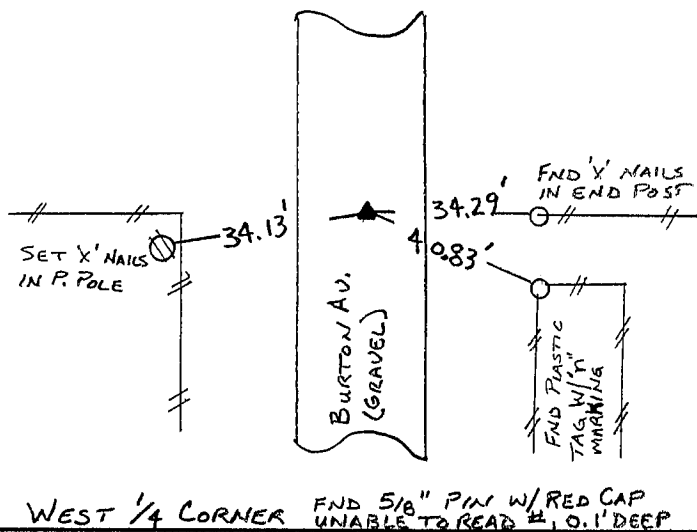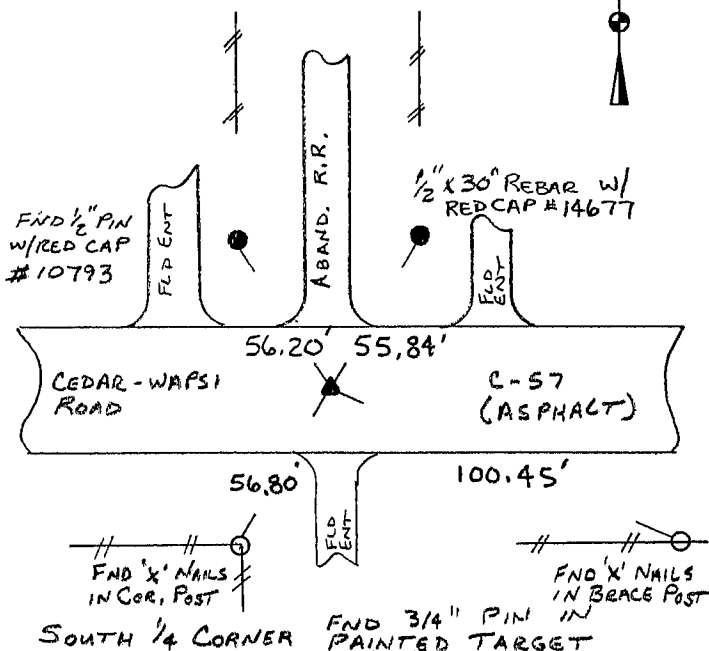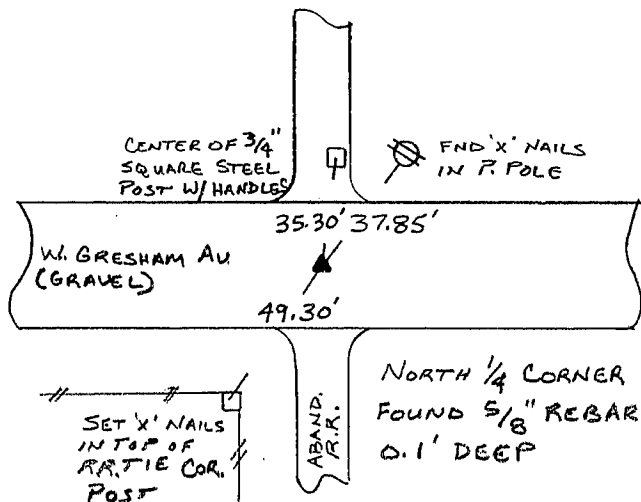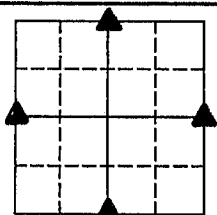

I hereby certify that this land surveying document was prepared and the related personal survey work was performed by me or under my direct personal supervision and that I am a duly Licensed Professional Land Surveyor under the laws of the State of Iowa.

Scott A. Steinfadt


4/17/01

Scott A. Steinfadt, P.L.S.

date

Iowa License No. 14677

My License Renewal Date is Dec. 31, 2003

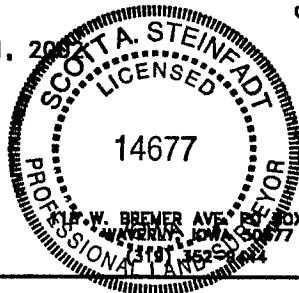

S & S
LAND SURVEYING, INC.

List Corners to be Indexed

Corners	Section	Twp	Range
N 1/4	11	90N	13W
E 1/4	11	90N	13W
S 1/4	11	90N	13W
W 1/4	11	90N	13W