

PREPARED BY:

BLACK HAWK COUNTY ENGINEERS OFFICE 316 E. FIFTH STREET, ROOM 211 WATER

WATERLOO, IOWA 50703

PH.# (319) 291-2419 FAX.# (319) 291-2461

SLSI 9-94 CERT 12-98

8

UNITED STATES PUBLIC LAND SURVEY CORNER CERTIFICATE OF

Land Survey Monuments situated in Section 17, Township 90 N, Range 12 W, of the Fifth Principal Meridian, BLACK HAWK County, Iowa. Previously recorded in Misc. Book N/A, Page N/A, in County Recorder's Office.

(Show reason for preparing this certificate, the evidence and detailed procedures used in establishing the corner positions and monumentation found or placed.)


Monument Description and Remarks: FOUND CONC. MONUMENT WITH TOP OFF LOC. 8" DEEP AND 4.50" SQ. - DRILLED PILOT @ CENTER AND SET 5/8" RBR. X 6" L. THROUGH CENTER OF CONCRETE MONUMENT. REBAR LOCATED 8" DEEP. MONUMENT RECOVERED SINCE ALL EXIST. CO. TIES OF RECORD DESTROYED AND EST. E. LINE OF S.E. 4 FOR BRIDGE REPLACEMENT PROJECT. ALSO SET 8" RBR. WITH CAP ALONG N. FACE C.M. @ 3" BELOW TOP (11" DEEP.)

PLAN - VIEW

(Show a minimum of three reference ties to durable physical objects, relevant monuments and physical conditions that will enable recovery of the corner.)

NOT TO SCALE



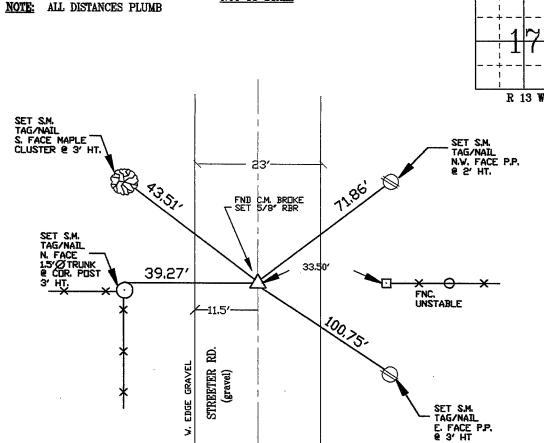

FIELD SURVEY: G. TINKER 05/27/98
PREPARED BY: E. GRIFFIN 05/27/98

CERTIFICATION

RICHARD L. SO KING S890

I hereby certify that this land surveying document was prepared and the related survey work was performed by me or under my direct personal supervision and that I am a duly licensed Land Surveyor under the laws of the State of Iowa.

Richard L. King (pate)
License Number 3890

My license renewal date is December 31, 1999

Pages or sheets covered by this seal:

This Land Corner Certificate Only.

LIST CORNERS TO BE INDEXED

<u>Corner</u> <u>Section</u> - <u>Township</u> - <u>Range</u> E. 1/4 17 90 N 13 W