

UNITED STATES PUBLIC LAND SURVEY
CORNER CERTIFICATE OF


LAND SURVEY SITUATED IN:	Section 18, Township 90 North, Range 13 West, of the Fifth Principal Meridian, Black Hawk County, Iowa.
PREVIOUSLY RECORDED IN BOOK:	Book 326 Misc, Page 480
INSTRUMENT #:	
FIELD WORK COMPLETED:	9/26/2019
SURVEY PREPARED BY: RESPOND TO:	CLAPSADDLE-GARBER ASSOCIATES, INC, 16 EAST MAIN STREET, P.O. BOX 754, MARSHALLTOWN, IOWA 50158 PHONE 641-752-6701 TSTEWART@CGACONSULTANTS.COM



Doc ID: 009804610002 Type: GEN
Recorded: 04/17/2020 at 02:14:23 PM
Fee Amt: \$0.00 Page 1 of 2
Black Hawk County Iowa
SANDIE L. SMITH RECORDER


File 2020-00017986

THIS CERTIFICATE WAS PREPARED TO PERPETUATE MONUMENTATION AFTER BLACK HAWK COUNTY HMA PAVEMENT WIDENING WITH HMA RESURFACING PROJECT STBG-SWAP-C007(136)--FG-07. CORNERS WERE SET USING METHODS DESCRIBED BELOW.

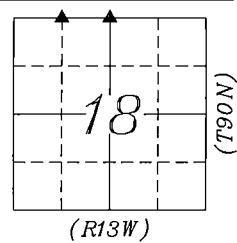

PLAN-VIEW
NO SCALE


- LEGEND:
- ▲ GOVERNMENT CORNER MONUMENT FOUND
 - △ GOVERNMENT CORNER MONUMENT SET
 - 1/2" x 30" REBAR w/ORANGE PLASTIC ID CAP #17162
 - //— EXISTING FENCE
 - NAIL w/SM NAIL WITH SURVEY MARKER

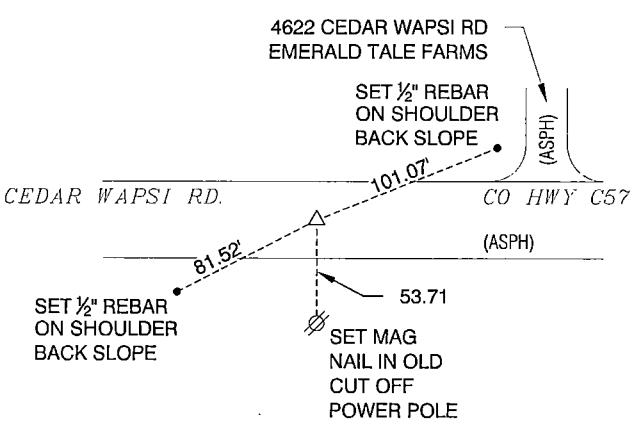

NE COR - NW 1/4 - NW 1/4
SECTION 18-90-13

SET MAG SPIKE AFTER PAVING
PROJECT WAS COMPLETE

CORNER IS 0.12' NORTH OF CL JOINT

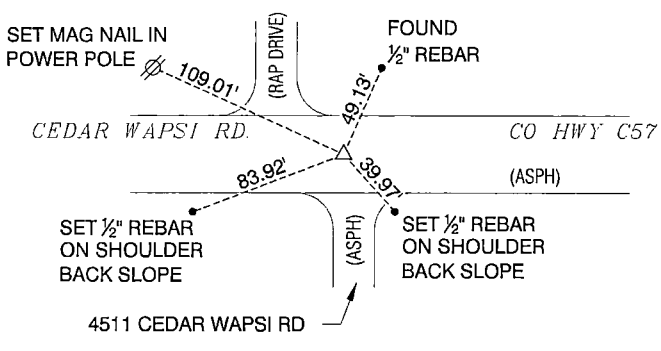

N1/4 COR
SECTION 18-90-13

SET MAG SPIKE AFTER PAVING
PROJECT WAS COMPLETE

CORNER IS 0.10' SOUTH OF CL JOINT



Clapsaddle-Garber Associates, Inc
16 East Main Street
Marshalltown, Iowa 50158
Ph 641 752-6701
www.cgaconsultants.com


DRAWN
SJC

DATE
09-30-2019

SHEET NO.
1 OF 2

PROJECT NO.
78321.05

List Corners to be Indexed			
Corners	Section	Township	Range
NE COR - NW 1/4-NW 1/4	18	90N	13W
NW COR - NE 1/4-NW 1/4	18	90N	13W
SE COR - SE 1/4-SW 1/4	07	90N	13W
SW COR - SE 1/4-SW 1/4	07	90N	13W
N 1/4 COR	18	90N	13W
S 1/4 COR	07	90N	13W

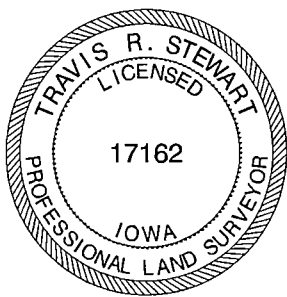

I hereby certify that this land surveying document was prepared and the related survey work was performed by me or under my direct personal supervision and that I am a duly Licensed Professional Land Surveyor under the laws of the State of Iowa.

Travis R. Stewart 10-10-2019
Travis R. Stewart, PLS date
Iowa License Number 17162
My License Renewal Date is December 31, 2019
Pages or sheets covered by this seal: THIS SHEET