

SLSI 9-90


(book, page, document number, etc.) _____ in County Recorder's Office.

(Show reason for preparing this certificate, the evidence and detailed procedures used in establishing the corner positions and monumentation found or placed.)

Monument Description and Remarks:

SET PIPE OVER.

PLAN - VIEW
(Show a minimum of three reference ties to durable physical objects, relevant monuments and physical conditions that will enable recovery of the corner.)

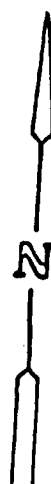

Signature: F. William King
Name typed or printed: F. WILLIAM KING
Date: 12-12

Date: 12-19-1991 Reg. No. 803/B

Corners	List Corners to be Indexed Section	Twp	Range
SE	19	30N	13W



MISC. BK. 299 p. 167