

INDEX
MARGIN
PROOF
COMPARE

FEE 1-5.00/

PRANGE SURVEYING

RECORDER

PREPARED BY: PRANGE SURVEYING, 3304 PANTHER LANE, CEDAR FALLS, IOWA 50613

SLSI 9-94
CERT 12-96

UNITED STATES PUBLIC LAND SURVEY CORNER CERTIFICATE OF
Land Survey Monuments situated in Section 24, Township 90N,
Range 13W, of the Fifth Principal Meridian, Black Hawk County, Iowa.
Previously recorded in Book , Page , in County Recorder's Office.

(Show reason for preparing this certificate, the evidence and detailed procedures used in establishing the corner positions and monumentation found or placed.)


Monument Description and Remarks: NW CORNER - Found Iowa D.O.T.
Pin w/cap 11" deep.

NE CORNER NW 1/4 - Found Concrete Monument 12" deep with bent
Iron Pin above. Set 1/2" x 7" Rebar w/cap No. 10040 above Monument

PLAN - VIEW

(Show a minimum of three reference ties to durable physical objects, relevant monuments and physical conditions that will enable recovery of the corner.)


NOT TO SCALE

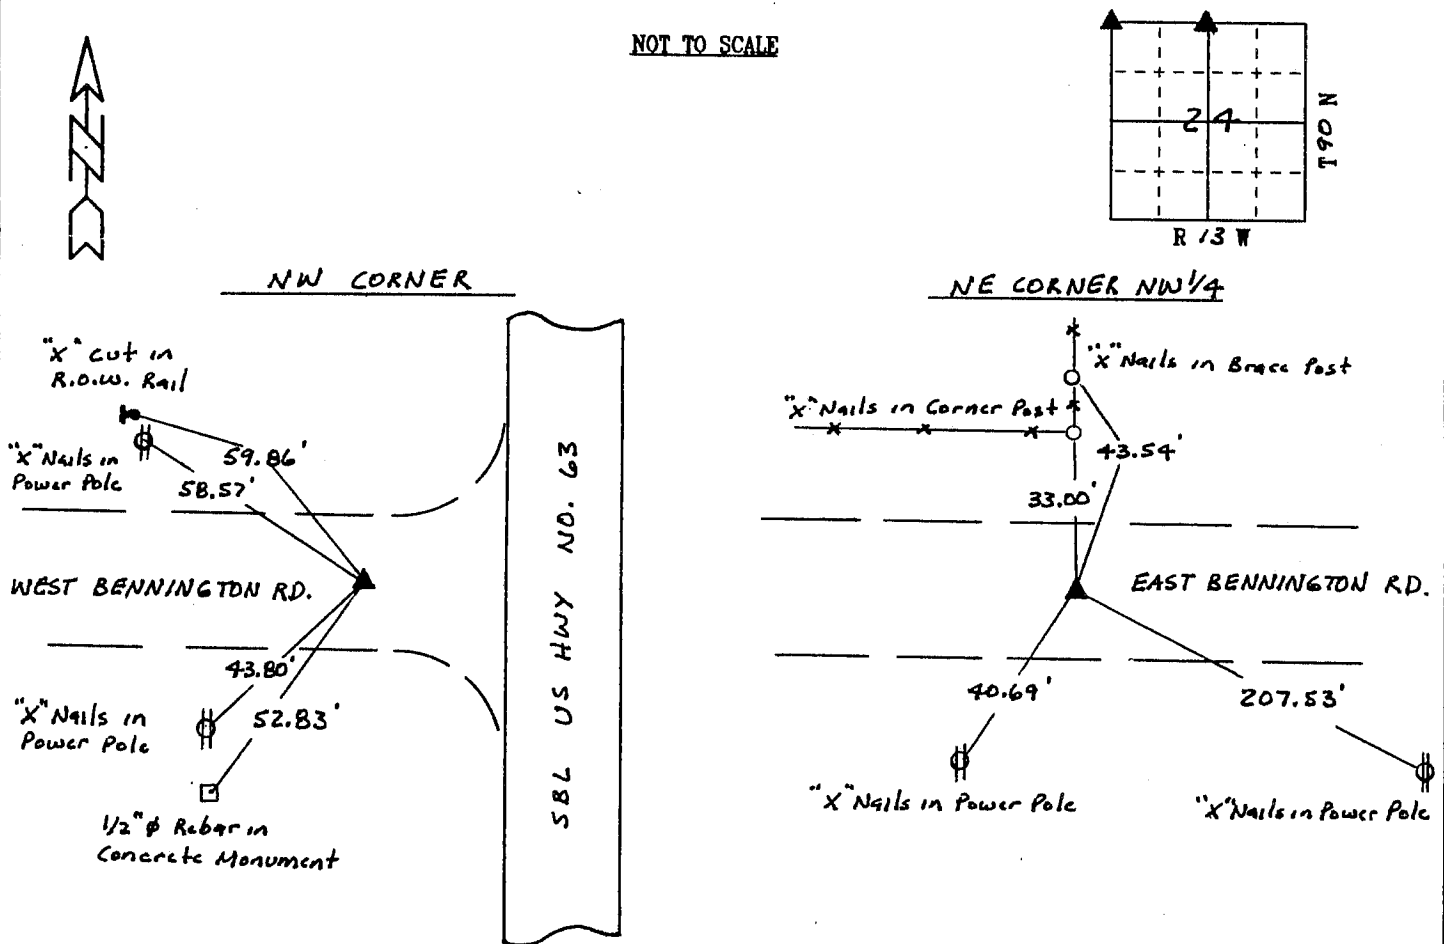

FIELD SURVEY: July 21, 2000

PREPARED BY: Dennis R. Prange

CERTIFICATION

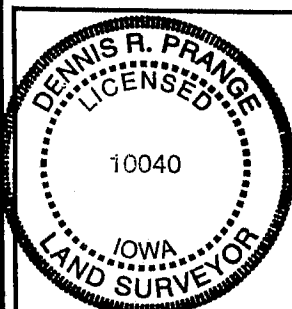

I hereby certify that this land surveying document was prepared and the related survey work was performed by me or under my direct personal supervision and that I am a duly licensed Land Surveyor under the laws of the State of Iowa.

Dennis R. Prange July 24, 2000
(date)

License Number 10040

My license renewal date is December 31, 2000

Pages or sheets covered by this seal:

This Land Corner Certificate Only.

LIST CORNERS TO BE INDEXED

Corner	Section	Township	Range
NW CORNER	24	T90N	R13W
NE CORNER	24	T90N	R13W
NW 1/4			