



PREPARED BY PATRICK SHEPARD: CIVIL ENGINEERING CONSULTANTS, INC. - 2400 86th ST. #12 -DES MOINES, IOWA 50322

# UNITED STATES PUBLIC LAND SURVEY CORNER CERTIFICATE OF

LAND SURVEY MONUMENTS SITUATED IN SECTION 24, TOWNSHIP 90 NORTH, RANGE 13 WEST, OF THE FIFTH PRINCIPAL MERIDIAN, BLACK HAWK COUNTY, IOWA. PREVIOUS RECORD FOUND AT THE BLACK HAWK COUNTY IN IDOT PLANS F-63-6(903)-20-07 ENGINEER'S OFFICE.


MONUMENT DESCRIPTION AND REMARKS:  
S 1/4 CORNER, 24-90-13. FOUND 1" FLAT BAR THAT MATCHES PREVIOUS RECORD. NO PREVIOUS TIES FOUND. THIS CERTIFICATE IS BEING PREPARED TO REPLACE LOST TIES.

## PLAN -VIEW

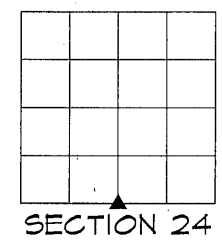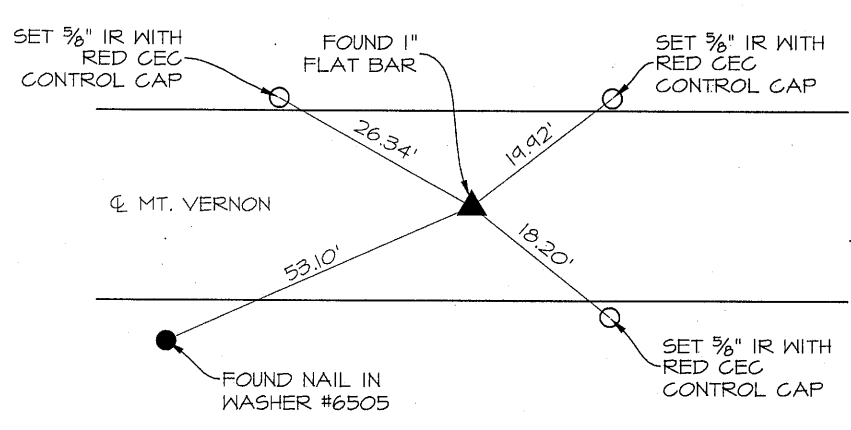

## LIST CORNERS TO BE INDEXED

CORNERS	SECTION	TWP.	RANGE
S 1/4 CORNER	24	90	13
N 1/4 CORNER	25	90	13



I HEREBY CERTIFY THAT THIS LAND SURVEYING DOCUMENT WAS PREPARED AND THE RELATED SURVEY WORK WAS PERFORMED BY ME OR UNDER MY DIRECT PERSONAL SUPERVISION AND THAT I AM A DULY LICENSED LAND SURVEYOR UNDER THE LAWS OF THE STATE OF IOWA.

*PS Shepard* 1-24-13  
PATRICK J. SHEPARD, IOWA LICENSE NO. 12265 DATE  
MY LICENSE RENEWAL DATE IS DECEMBER 31, 2013  
PAGES OR SHEETS COVERED BY THIS SEAL:  
THIS SHEET ONLY

(7-00)