Document Number: 2008009163

Date: Oct 29, 2007 4:30:00 pm

Aud Fee: 0.00 Rec Fee: Trans Tax: 0.00 Rec Management Fee:

E-Com Fee: 0.00 Non-Standard Page Fee:

Filed for record in Black Hawk County, Iowa

 \mathbf{Z}

Judith A. McCarthy, County Recorder

PREPARED BY:

BLACK HAWK COUNTY ENGINEERS OFFICE

WATERLOO, IOWA 50703 316 E. FIFTH STREET, ROOM 211

PH.# (319) 833-3008 FAX.# (319) 833-3139

0.00

SLSI 9-94 CERT 12-96

0.00

0.00

UNITED STATES PUBLIC LAND SURVEY CORNER CERTIFICATE OF


Land Survey Monuments situated in Section 27 __ , Township___<u>90</u> Range 13 , of the Fifth Principal Meridian, BLACK HAWK County, Iowa. Previously recorded in Misc. Book n/a, Page n/a, in County Recorder's Office.

(Show reason for preparing this certificate, the evidence and detailed procedures used in establishing the corner positions and monumentation found or placed.)

Monument Description and Remarks: SET #5 REBAR x ±32" L. w/ YELLOW PLASTIC CAP #15748 AT MID POINT EAST LINE OF S.E. 1/4, & LOCATED \pm C.L. GRAVEL ROAD @ 2" DEEP. CORNER EST. FOR SURVEY OF S.E. 1/4 SAID SECT.

PLAN - VIEW

(Show a minimum of three reference ties to durable physical objects, relevant monuments and physical conditions that will enable recovery of the corner.)

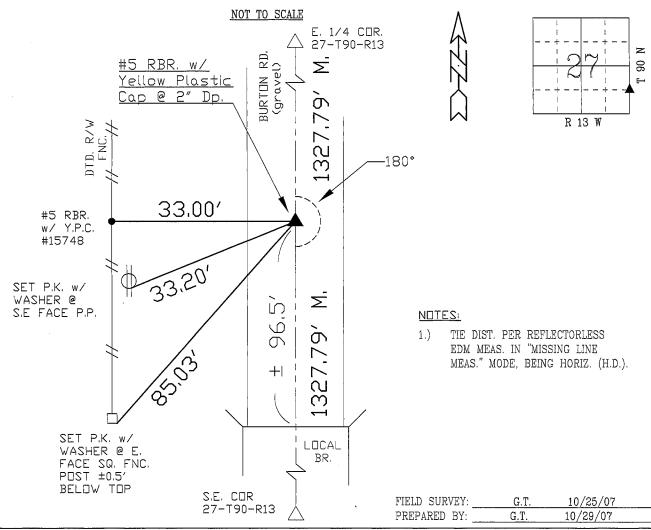

<u>CERTIFICATION</u>



I hereby certify that this land surveying document was prepared and the related survey work was performed by me or under my direct personal supervision and that I am a duly licensed Land Surveyor under the laws of the State of Iowa.

10/29/07 15748

2008 My license renewal date is December 31,_

Pages or sheets covered by this seal:

This Land Corner Certificate Only.

LIST CORNERS TO BE INDEXED

ŀ						
	<u>Corner</u>	Section	_	Township	-	<u>Range</u>
	N.E. COR. S.E.1/4-S.			90		13
	N.W. COR. S.W.1/4-S.	26 W.1/4		90		13