

MSC  
INDEX  
MARGIN  
PROOF  
COMPARE

BLACK HAWK COUNTY IOWA: SS  
Filed for record Sep 28, 1998, at  
4:00 P.M. and recorded in Book 331  
of Misc Page 704.  
*Patricia S. Sess* Recorder  
Fee n/c  
ENGINEER'S OFFICE

7242

County Recorder

PREPARED BY: BLACK HAWK COUNTY ENGINEERS OFFICE  
316 E. FIFTH STREET, ROOM 211 WATERLOO, IOWA 50703

PH.# (319) 291-2419  
FAX.# (319) 291-2461  
SLSI 9-94  
CERT 12-98


UNITED STATES PUBLIC LAND SURVEY CORNER CERTIFICATE OF  
Land Survey Monuments situated in Section 28, Township 90 N,  
Range 13 W, of the Fifth Principal Meridian, BLACK HAWK County, Iowa.  
Previously recorded in Misc. Book N/A, Page N/A, in County Recorder's Office.

(Show reason for preparing this certificate, the evidence and detailed procedures used in establishing the corner positions and monumentation found or placed.)


Monument Description and Remarks: FOUND LEAD PLUG LOC. 1.20' W. OF CL  
JOINT AT THE INTERSECTION OF WAGNER RD. AND MT. VERNON RD. REPLACE  
EXIST. COUNTY TIES OF 1974 ARE OF THAT FOUND, AGREE +/- TO +.20'  
RE-SET WITH 5/8" REBAR x 6" L. A.C.C. SURFACE.  
RETIED DUE TO A.C.C. RESURFACING PROJECT.

### PLAN - VIEW

(Show a minimum of three reference ties to durable physical objects, relevant monuments and physical conditions that will enable recovery of the corner.)

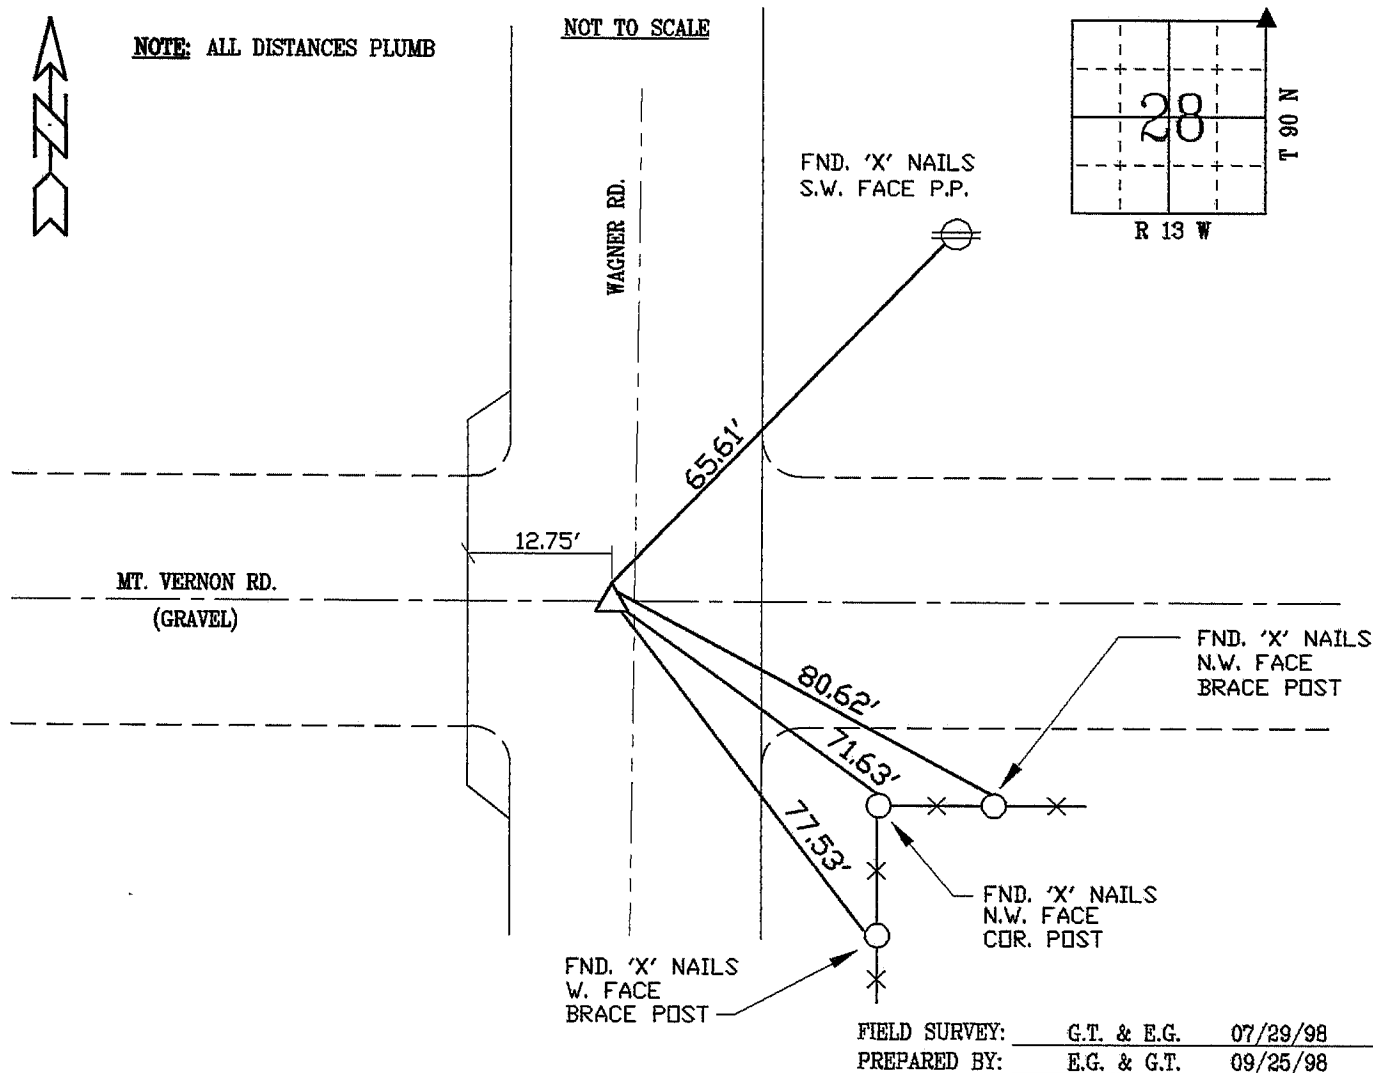

### CERTIFICATION

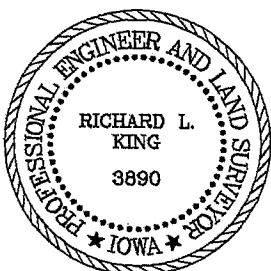

I hereby certify that this land surveying document was prepared and the related survey work was performed by me or under my direct personal supervision and that I am a duly licensed Land Surveyor under the laws of the State of Iowa.

*Richard L. King* 9/25/98  
Richard L. King (date)

License Number 3890

My license renewal date is December 31, 1999

Pages or sheets covered by this seal:

This Land Corner Certificate Only.

### LIST CORNERS TO BE INDEXED

Corner	Section	Township	Range
N.E. COR.	28	90 N	13 W

BOOK **331** PAGE **704**