

UNITED STATES PUBLIC LAND SURVEY CORNER CERTIFICATE

OF


Land Survey Monuments situated in Section 29, Township 90 NORTH, Range 13 W ST of the Fifth Principal Meridian, BLACK HAWK County, Iowa.
Previously recorded in Book _____, Page _____

Show reason for preparing this certificate, the evidence and detailed procedures used in establishing the corner positions and monument found or placed.)
Monument Description and Remarks: FOUND A CLINCH-TOP PIN 4" DEEP IN CENTER

OF INTERSECTION OF GRAVEL ROADS


PLAN - VIEW

(Show a minimum of three reference ties to durable physical objects, relevant monuments and physical conditions that will enable recovery of the corner.)

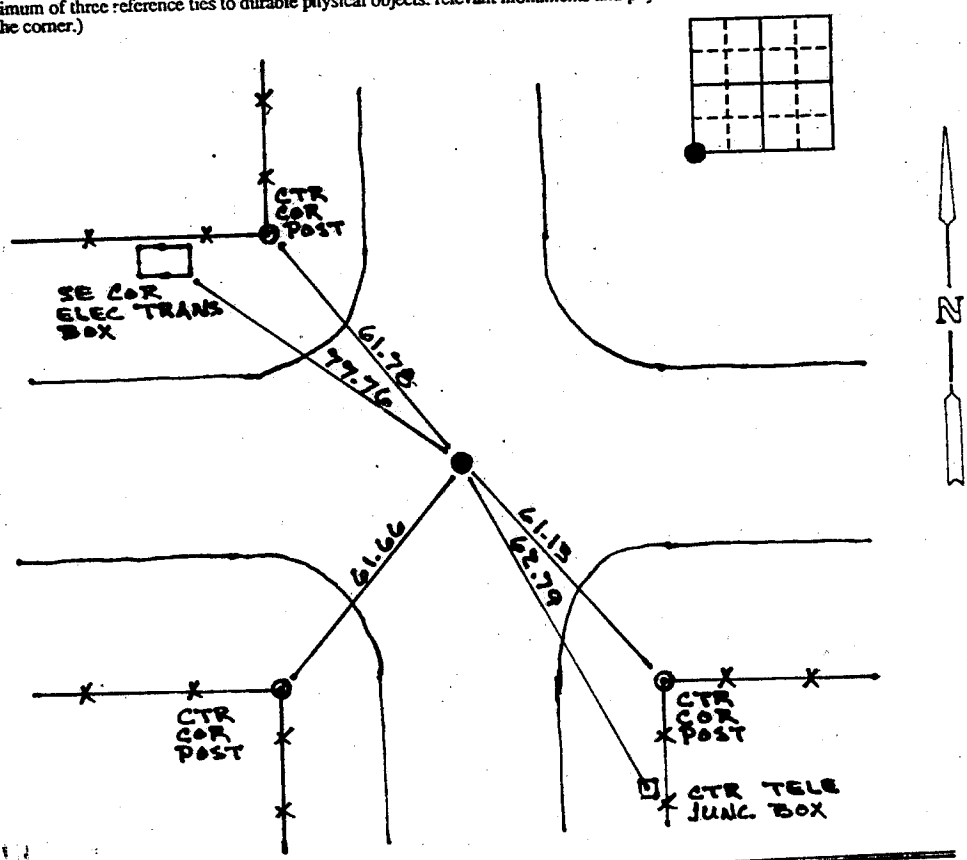

I hereby certify that the survey work was completed and this certificate was prepared by me or under my direct personal supervision and that I am a duly registered land surveyor under the laws of the state of Iowa.

Wm H Robinson
REGISTERED LAND SURVEYOR NO. 2697
DATE 1/31/91
SEAL

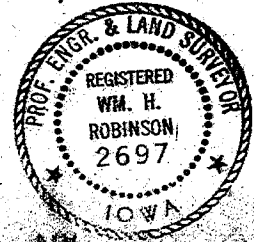

List Corners to be Indexed

Corners	Section	Twp	Range
SW	29	90	13