

UNITED STATES PUBLIC LAND SURVEY CORNER CERTIFICATE


OF

Land Survey Monuments situated in Section 29 Township 90 NORTH Range 13 WEST
 of the Fifth Principal Meridian, BLACK HAWK County, Iowa.
 Previously recorded in Book _____, Page _____.

(Show reason for preparing this certificate, the evidence and detailed procedures used in establishing the corner positions and monument location found or placed.)
 Monument Description and Remarks: FOUND A BROKEN CONCRETE MONUMENT 4" DEEP
IN CENTER OF GRAVEL ROAD WITH IRON PIN BESIDE MONUMENT

PLAN - VIEW

(Show a minimum of three reference ties to durable physical objects, relevant monuments and physical conditions that will establish recovery of the corner.)

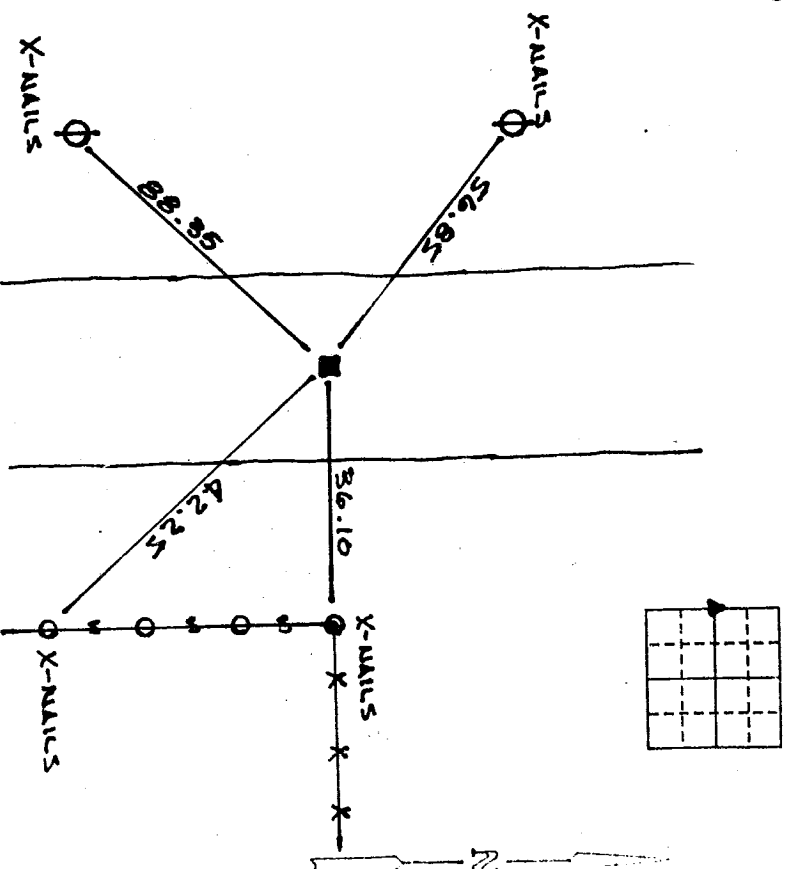

List Corners to be Indexed

| Corners | Section | Twp | Range |
|---------|---------|-----|-------|
| W 1/4 | 29 | 90 | 13 |

I hereby certify that the survey work was completed and this certificate was prepared by me or under my direct personal supervision and that I am a duly registered land surveyor under the laws of the state of Iowa.

Wm. H. Robinson
 REGISTERED LAND SURVEYOR NO. 2697

DATE 1/31/91
 SEAL

