

INDEX

BLACK HAWK COUNTY, IOWA:ss

FEE BOOK # 2003 23392

PROOF

FILED FOR RECORD FEB 13, 2003, AT 11:30 A.M. FEE 1-5.00/

COMPARED

Dennis R. Prange

BLACK HAWK COUNTY RECORDER

PRANGE SURVEYING 3304 PANTHER LANE CEDAR FALLS IA 50613

Prepared by Dennis R. Prange, L.S., Prange Surveying, 3304 Panther Lane, Cedar Falls, Iowa 50613, (319) 277-4935

UNITED STATES PUBLIC LAND SURVEY CORNER CERTIFICATE
OF


Land Survey Monuments situated in Section No. 30, Township No. 90 North, Range No. 13 West, of the Fifth Principal Meridian, Black Hawk County, Iowa.
Previously recorded in Book N/A on Page N/A in the office of the County Recorder.
(book, page, document number, etc.)

(Show reason for preparing this certificate, the evidence and detailed procedures used in establishing the corner positions and monumentation found or placed.)

Monument Description and Remarks: Found 5/8"Ø Iron Pin - Location verified
with Iowa D.O.T. ties

PLAN - VIEW

(Show a minimum of three reference ties to durable physical objects, relevant monuments and physical conditions that will enable recovery of the corner.)

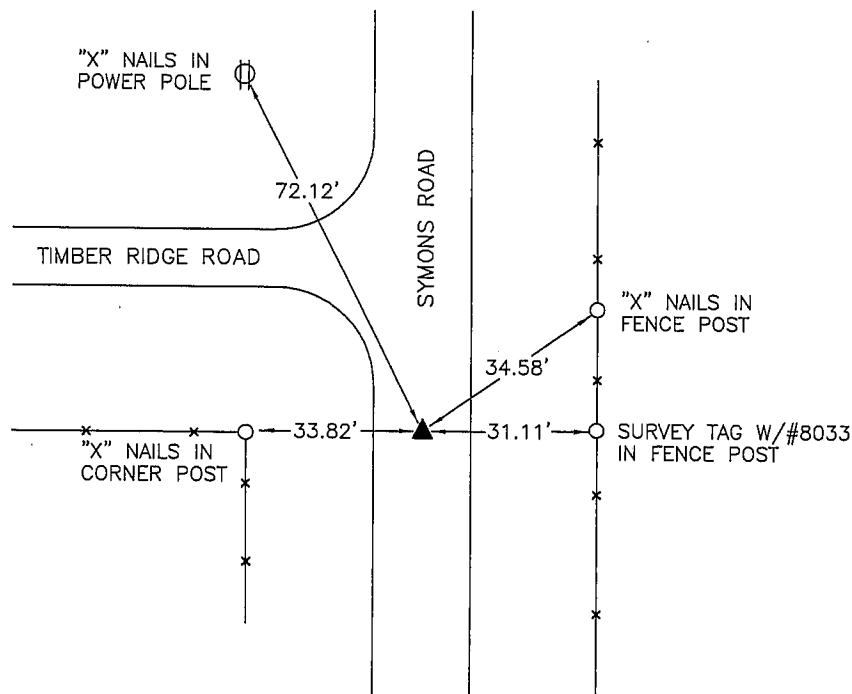
NOT TO SCALE

I hereby certify that this land surveying document was prepared by me or under my direct personal supervision and that I am a duly licensed Professional Land Surveyor under the laws of the State of Iowa.

Signed: Dennis R. Prange
Dennis R. Prange, L.S. Iowa License No. 10040

Date: January 21, 2003

SEAL

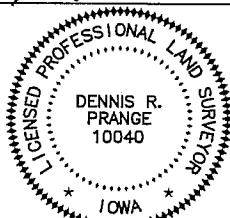

My License renewal date is December 31, 2004.
Pages or sheets covered by this seal : this page only

Corners	List Corners to be Indexed Section	Twp	Range
CENTER	30	90	13

Drawn by: DRP

Checked by: