

UNITED STATES PUBLIC LAND SURVEY CORNER CERTIFICATE

SLSI 9-90

OF


of the Fifth Principal Meridian, BLACK HAWK County, Iowa.
Previously recorded in 414 in County Recorder's Office.

(Show reason for preparing this certificate, the evidence and detailed procedures used in establishing the corner positions and monuments found or placed.)

Monument Description and Remarks: Found 4 1/2" Red Pine #3362 using CES TWS
of 1982. When 5th Cnc. Mon. was found @ 2.5' Deep. In 1982, a CLIP PIPE
WAS SET ON THE NORTH SIDE OF THE MONUMENT & THE CAPED PIN WAS SET
ON THE S.W. MONUMENT.

PLAN - VIEW

(Show a minimum of three reference ties to durable physical objects, relevant monuments and physical conditions that will enable recovery of the corner.)

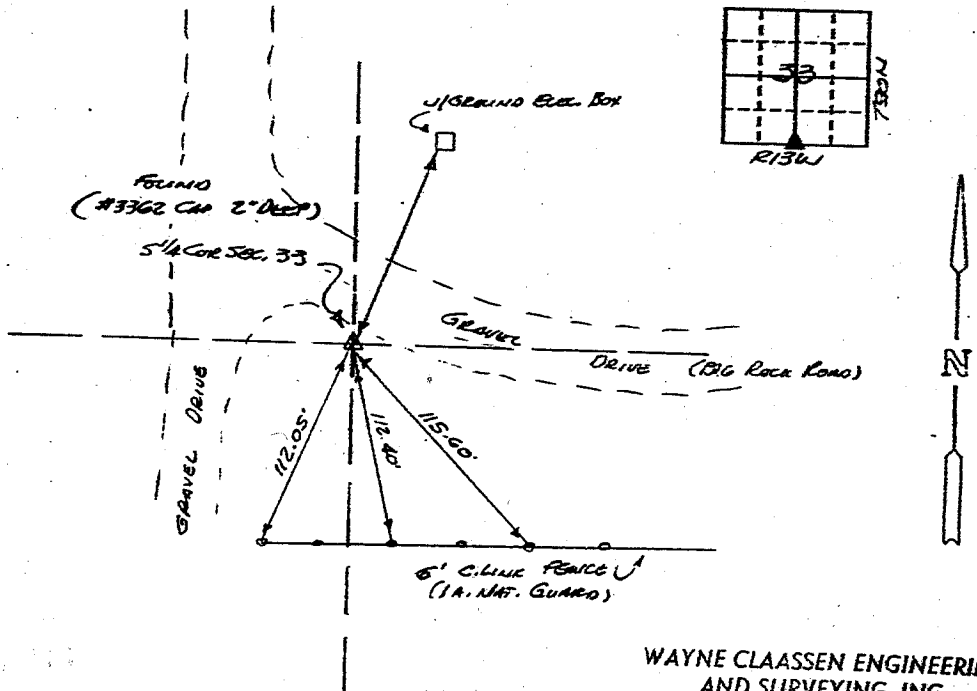

305-43
241-62

WAYNE CLAASSEN ENGINEERING
AND SURVEYING, INC.
2709 UNIVERSITY AVE.
P.O. BOX 898
WATERLOO, IA 50704

I hereby certify that the survey work was completed and this certificate was prepared by me or under my direct personal supervision and that I am a duly registered land surveyor under the laws of the state of Iowa.

Signature: F. William King
Name typed or printed: F. William King
Date: 1-5-1985 Reg. No. 8033



Corners	Section	Twp	Range
